

STATE CORPORATION COMMISSION OF KANSAS  
OIL & GAS CONSERVATION DIVISION  
WELL COMPLETION OR RECOMPLETION FORM  
ACO-1 WELL HISTORY  
DESCRIPTION OF WELL AND LEASE

Operator: License # 3536  
Name Ramco Oil and Gas Corporation  
Address P.O. Box 99  
City/State/Zip Belpre, Ohio 45714

Purchaser.....

Operator Contact Person Dave Gocke  
Phone (614) 423-9591

Contractor: License # 5418  
Name Allen Drilling Company

Wellsite Geologist Scott Alberg STATE CORPORATION COMMISSION  
Phone (316) 672-5729

Designate Type of Completion  
 New Well  Re-Entry  Workover  
 Oil  SWD  Temp Abd  
 Gas  Inj  Delayed Comp.  
 Dry  Other (Core, Water Supply etc.)

If OHWO: old well info as follows:  
Operator .....  
Well Name .....  
Comp. Date ..... Old Total Depth.....


WELL HISTORY

Drilling Method:  
 Mud Rotary  Air Rotary  Cable  
10/15/88 10/24/88 10-25-88  
Spud Date Date Reached TD Completion Date  
4765' .....  
Total Depth PBTD  
Amount of Surface Pipe Set and Cemented at 258 feet  
Multiple Stage Cementing Collar Used?  Yes  No  
If yes, show depth set.....feet  
If alternate 2 completion, cement circulated from.....feet depth to.....w/.....SX cmt  
Cement Company Name .....  
Invoice # .....  
AIR DYO

API NO. 15-007-22,209  
County Barber  
E/2 NE SE Sec. 10 Twp 30 Rge. 13 East  
1980 Ft North from Southeast Corner of Section  
535 Ft West from Southeast Corner of Section  
(Note: Locate well in section plat below)

Lease Name Eugene R. Lawrenz Well # 1  
Field Name Sawyer  
Producing Formation D & A  
Elevation: Ground 1855 KB 1860

Section Plat

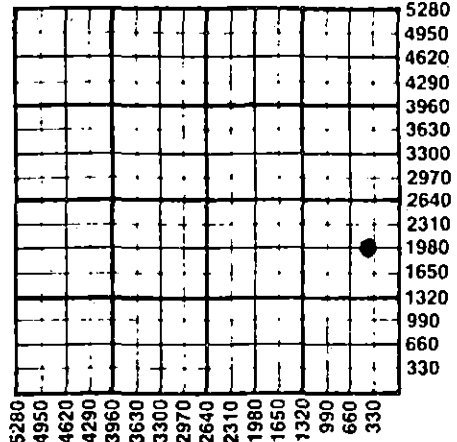

WATER SUPPLY INFORMATION

Disposition of Produced Water:  Disposal  
Docket # .....  Repressuring

Questions on this portion of the ACO-1 call:  
Water Resources Board (913) 296-3717

Source of Water:  
Division of Water Resources Permit #.....  
 Groundwater.....Ft North from Southeast Corner  
(Well) .....Ft West from Southeast Corner of  
Sec Twp Rge East West  
 Surface Water.....Ft North from Southeast Corner  
(Stream, pond etc).....Ft West from Southeast Corner  
Sec Twp Rge East West  
3/4 mile East of location  
 Other (explain).....  
(purchased from city, R.W.D. #)

INSTRUCTIONS: This form shall be completed in triplicate and filed with the Kansas Corporation Commission, 200 Colorado Derby Building, Wichita, Kansas 67202, within 120 days of the spud date of any well. Rule 82-3-130, 82-3-107 and 82-3-106 apply. Information on side two of this form will be held confidential for a period of 12 months if requested in writing and submitted with the form. See rule 82-3-107 for confidentiality in excess of 12 months. One copy of all wireline logs and drillers time log shall be attached with this form. Submit CP-4 form with all plugged wells. Submit CP-111 form with all temporarily abandoned wells.

All requirements of the statutes, rules and regulations promulgated to regulate the oil and gas industry have been fully complied with and the statements herein are complete and correct to the best of my knowledge.

Signature .....  
Title V.P. Engineering Date 11-5-88  
Subscribed and sworn to before me this 5th day of Nov. 1988  
Notary Public Jo Ann Watson  
Date Commission Expires Jan. 20, 1991

Jo Ann Watson, Notary Public,  
State of Ohio, My Commission  
Expires January 20, 1991.

K.C.C. OFFICE USE ONLY  
F Letter of Confidentiality Attached  
C  Wireline Log Received  
C  Drillers Timelog Received  
Distribution  
 KCC  SWD/Rep  NGPA  
 KGS  Plug  Other  
(Specify)  
11-9-88

Section 20 Twp 30 Rge 13 E

