

15-033-20133-0000


STATE OF KANSAS
STATE CORPORATION COMMISSION

WELL PLUGGING RECORD

Give All Information Completely
Make Required Affidavit
Mail or Deliver Report to:
Conservation Division
State Corporation Commission
800 Biting Building
Wichita, Kansas

Comanche County, Sec. 5 Twp. 32S Rge. ~~17~~ 17 (W)
Location as "NE/CNW/SW" or footage from lines C NW/4 SE/4
Lease Owner Graham-Michaelis Corporation
Lease Name Lill Well No. 1-5
Office Address P. O. Box 247, Wichita, Kansas 67201
Character of Well (completed as Oil, Gas or Dry Hole) Dry Hole
Date well completed May 31, 1973
Application for plugging filed May 31, 1973
Application for plugging approved June 1, 1973
Plugging commenced May 31, 1973
Plugging completed May 31, 1973
Reason for abandonment of well or producing formation

NORTH

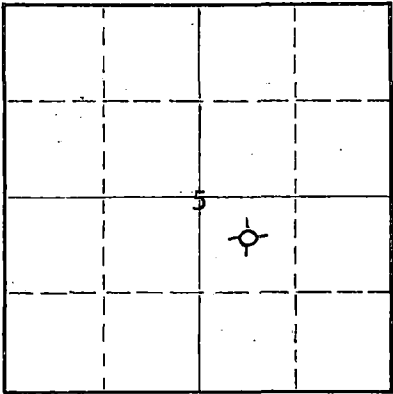

Locate well correctly on above Section Plat

If a producing well is abandoned, date of last production 19
Was permission obtained from the Conservation Division or its agents before plugging was commenced? Yes (verbal)

Name of Conservation Agent who supervised plugging of this well G. Russell Biberstein, Attica, Ks.
Producing formation Depth to top Bottom Total Depth of Well 5256 Feet
Show depth and thickness of all water, oil and gas formations.

OIL, GAS OR WATER RECORDS

CASING RECORD

| FORMATION | CONTENT | FROM | TO | SIZE | PUT IN | PULLED OUT |
|-----------|---------|------|----|--------|--------|------------|
| | | | | 8 5/8" | 664' | none |
| | | | | | | |
| | | | | | | |
| | | | | | | |
| | | | | | | |
| | | | | | | |
| | | | | | | |

Describe in detail the manner in which the well was plugged, indicating where the mud fluid was placed and the method or methods used in introducing it into the hole. If cement or other plugs were used, state the character of same and depth placed, from feet to feet for each plug set.

Plugged with 50 sacks cement at 700', heavy rotary mud to 40', 15 sacks cement from 40' to bottom of cellar, 2 sacks of cement in rat hole.

RECEIVED
STATE CORPORATION COMMISSION
JUN 11 1973
6-11-73
CONSERVATION DIVISION
Wichita, Kansas

(If additional description is necessary, use BACK of this sheet)
Name of Plugging Contractor Garvey Drilling Company
Address RFD #2, Great Bend, Kansas 67530

STATE OF Kansas, COUNTY OF Sedgwick, ss.
Jack L. Yinger (employee of owner) or (owner or operator) of the above-described well, being first duly sworn on oath, says: That I have knowledge of the facts, statements, and matters herein contained and the log of the above-described well as filed and that the same are true and correct. So help me God.

(Signature) Jack L. Yinger - Geologist
(Address)

SUBSCRIBED AND SWORN TO before me this 6th day of June, 1973

Muriel F. C. Jeram
Notary Public.

My commission expires

MURIEL F. C. JERAM
NOTARY PUBLIC
SEDGWICK COUNTY, KANSAS
MY COMMISSION EXPIRES
JULY 25, 1976

15-033-2033-0000

RECEIVED

WELL LOG

JUN 8 1973
Graham-Michaelis Corp.
Wichita, Kansas

COMPANY **Graham-Michaelis Corporation**

SEC. 5 T. 32S R. 17W

FARM **Lill** NO. **1-5**


LOC. **NW SE**

TOTAL DEPTH **5256'**

COUNTY **Comanche, Kansas**

COMM. **5-19-73** COMP. **5-31-73**

CONTRACTOR **Garvey Drilling Company**

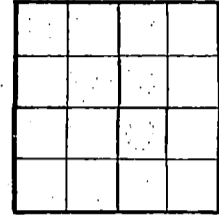

CASING
8 5/8" @ 653' w/500sx

ELEVATION **2131 GL**

PRODUCTION **D & A**

FIGURES INDICATE BOTTOM OF FORMATIONS

- 200' Sand
- 410' Red Bed
- 667' Red Bed & Shale
- 1125' Shale
- 2385' Shale & Lime
- 2510' Lime & Shale
- 4500' Shale
- 4540' Lime & Shale
- 4660' Lime
- 5256' Mississippi
- 5256' RTD

RECEIVED
STATE CORPORATION COMMISSION

JUN 11 1973
6-11-73
CONSERVATION DIVISION
Wichita, Kansas

State of Kansas }
County of Barton } SS

I, Charlene M. Marker of Garvey Drilling Company

upon oath state the above and foregoing is a true and correct copy of the log of the Lill #1-5 well.

Charlene M. Marker

Subscribed and sworn to before me this 4th day of June 19 73

My Commission Expires: April 14, 1975

Charles J. Miles
NOTARY PUBLIC