


STATE OF KANSAS  
STATE CORPORATION COMMISSION  
200 Colorado Derby Bldg.  
Wichita, Kansas 67202

Form CP-4  
Rev. 12-15-80

WELL PLUGGING RECORD

Give All Information Completely  
Make Required Affidavit

COUNTY COMANCHE SEC. 3 TWP. 32S RGE. 17W E/W  
Location as in quarters or footage from lines:  
C SE SW

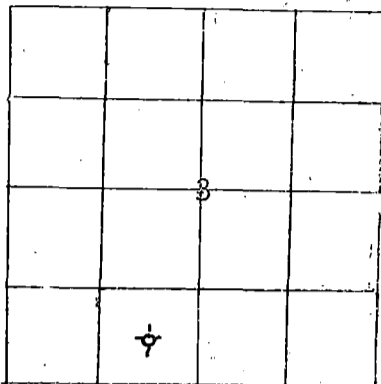

Locate Well  
correctly on above  
Section Platt.

Lease Owner American Energies Corporation  
Lease Name York Well No. 1  
Office Address 575 Fourth Financial Center, Wichita, KS 67202  
Character of Well (Completed as Oil, Gas or Dry Hole): Dry Hole  
Date Well Completed January 22, 1982  
Application for plugging filed January 22, 1982  
Plugging commenced January 22, 1982  
Plugging completed January 22, 1982  
Reason for abandonment of well or producing formation \_\_\_\_\_

Was permission obtained from the Conservation Division or it's  
Agent's before plugging was commenced? yes

Name of Conservation Agent who supervised plugging of this well Paul Luthi, Minneola, KS  
Producing formation \_\_\_\_\_ Depth to top \_\_\_\_\_ bottom \_\_\_\_\_ T.D. 5220  
Show depth and thickness of all water, oil and gas formations.

OIL, GAS OR WATER RECORDS

Casing Record

Formation	Content	From	To	Size	Put in	Pulled Out
Surface	shale&sand	0	628	8-5/8"	625'	none
	cemented with 250 sx lite, 3%cc, followed w/250 sx common 2%gel, 3% cc, circulated, plug down at 2:30 p.m. 1-13-82 by Halliburton.					

Describe in detail the manner in which the well was plugged, indicating where the mud  
fluid was placed and the method or methods used in introducing it into the hold. If cement  
or other plugs were used, state the character of same and depth placed, from \_\_\_\_\_ feet  
to \_\_\_\_\_ feet for each plug set.

Plugged as follows: Filled hole w/mud, pushed rubber plug to 615'; pumped  
40 sx 50/50 posmix, 2%cc, thru open end drill pipe, mud to 40', 1/2 sx bulls  
and wood plug for solid bridge, pumped 10 sx to base of cellar, 10 sx in  
rat hole, 5 sx in mousehole, completed @ 4:30 p.m. 1-22-82 by Halliburton.

(If additional description is necessary, use BACK of this sheet)

Name of Plugging Contractor Husky Drilling Co., Inc.

STATE OF KANSAS COUNTY OF SEDGWICK, ss.

Jon T. Williams, Jr. (employee of owner) or (owner or operator) of the  
above-described well, being first duly sworn on oath, says: That I have knowledge of the  
facts, statements, and matters herein contained and the log of the above-described well as  
filed and that the same are true and correct. So help me God.

**RECEIVED**  
**FEB 10 1982**  
**2-10-82**  
CONSERVATION DIVISION  
Wichita, Kansas

HUSKY DRILLING CO. INC.  
(Signature) By [Signature]  
200 E. First, Suite 500, Wichita, KS  
(Address)

AND SWORN TO before me this 22nd day of January, 19 82

My Commission expires: January 14, 1985

Geraldine Stewart  
Geraldine Stewart Notary Public.

