


STATE OF KANSAS
STATE CORPORATION COMMISSION
CONSERVATION DIVISION
P. O. BOX 17027
WICHITA, KANSAS 67217

FORM CP-4

WELL PLUGGING RECORD

Comanche County, Sec. 3 Twp. 32S Rge. (E) 17 (W)

Location as "NE/CNW/SE" or footage from lines C NW SE
Lease Owner K. R. M. Petroleum Corporation
Lease Name L. W. York Well No. 1
Office Address 817 Seventh St. Denver, Colorado 80202
Character of Well (completed as Oil, Gas or Dry Hole) Dry Hole
Date well completed February 18, 1977
Application for plugging filed February 18, 1977
Application for plugging approved February 18, 1977
Plugging commenced February 18, 1977
Plugging completed February 18, 1977
Reason for abandonment of well or producing formation dry hole

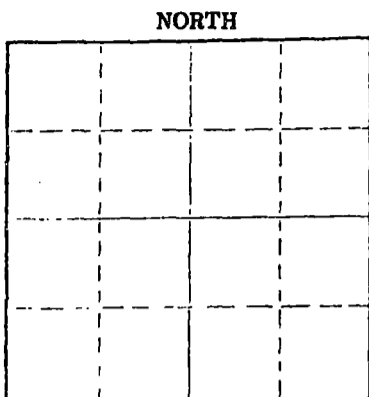

Locate well correctly on above Section Plat

If a producing well is abandoned, date of last production 19
Was permission obtained from the Conservation Division or its agents before plugging was commenced? yes

Name of Conservation Agent who supervised plugging of this well Bud Metz - Stafford, Kansas
Producing formation Depth to top Bottom Total Depth of Well 525 Feet
Show depth and thickness of all water, oil and gas formations. 5215

OIL, GAS OR WATER RECORDS

CASING RECORD

FORMATION	CONTENT	FROM	TO	SIZE	PUT IN	PULLED OUT
	Surface Casing	0	614'	8 5/8"	614'	none

Describe in detail the manner in which the well was plugged, indicating where the mud fluid was placed and the method or methods used in introducing it into the hole. If cement or other plugs were used, state the character of same and depth placed, from feet to feet for each plug set.

Set Plug at 400' with 35 sacks cement,
plug at 40' with 15 sacks cement,
5 sacks in rat hole, Job completed 2-18-77.

RECEIVED
STATE CORPORATION COMMISSION
FEB 22 1977
2-22-77
CONSERVATION DIVISION
Wichita, Kansas

(If additional description is necessary, use BACK of this sheet)
Name of Plugging Contractor Search Drilling Company
Address Wichita, Kansas

STATE OF Kansas COUNTY OF Sedgwick, ss.
R. M. Stagl (employee of owner) or (owner or operator) of the above-described

well, being first duly sworn on oath, says: That I have knowledge of the facts, statements, and matters herein contained and the log of the above-described well as filed and that the same are true and correct. So help me God.

(Signature) R. M. Stagl
Wichita, Kansas

SUBSCRIBED AND SWORN TO before me this 18th day of February, 1977

My commission expires February 19, 1977

Maxine Dressen
Maxine Dressen Notary Public.

MAXINE DRESSEN
NOTARY PUBLIC
SEDGWICK COUNTY, KANSAS
MY COMM. EXP. FEB. 19, 1977

15-033-20220-0000

DRILLERS LOG

#1 L. W. York

CASING RECORD:
8 5/8" set at 614'
with 300 sack cement

OPERATOR: K. R. M. Petroleum Corp.

DESCRIPTION:

CONTRACTOR: Search Drilling Company

C NW SE,
Section 3-32S-17W
Comanche County,
Kansas

TOTAL DEPTH:

COMMENCED: February 9, 1977

5215'

COMPLETED: February 18, 1977

<u>FORMATION</u>	<u>FROM</u>	<u>TO</u>	<u>REMARKS</u>
Clay-Sand-Gravel	0	200	
Clay-Shale	200	260	
Red Bed-Sand-Clay	260	628	
Clay Shale	628	760	
Red Bed and Shale	760	1680	
Shale and Lime	1680	2082	
Shale and Lime	2082	2745	
Lime and Shale	2745	3224	
Lime and Shale	3224	3830	
Lime and Shale	3830	4400	
Lime and Shale	4400	4888	
Lime and Shale	4888	5122	
Lime and Chert	5122	5143	
Lime and Shale	5143	5215	
Rotary Total Depth	5215		D & A

RECEIVED
STATE CORPORATION COMMISSION
FEB 22 1977
2-22-77
CONSERVATION DIVISION
Wichita, Kansas

I certify that this is a true and correct copy of the above log to the best of my knowledge.

SEARCH DRILLING COMPANY

R. M. Stagl
R. M. Stagl

Subscribed and sworn to before me this 18th day of February, 1977.

My commission expires:
February 19, 1977

Maxine Dressen
Maxine Dressen Notary Public

MAXINE DRESSEN
NOTARY PUBLIC
SEDGWICK COUNTY, KANSAS
MY COMM. EXP. FEB. 19, 1977