


WELL PLUGGING RECORD

Use All Information Completely  
Take Required Affidavit  
File or Deliver Report to:  
Conservation Division  
State Corporation Commission  
211 No. Broadway  
Wichita, Kansas

Comanche County, Sec. 6 Twp. 32S Rge. (X) 17 (W)

Location as "NE/CNW/SW" or footage from lines C SE NW  
Lease Owner: Ashland Oil & Refining Company  
Lease Name: Lawrence York Well No. 1  
Office Address: Box 949, Liberal, Kansas  
Character of Well (completed as Oil, Gas or Dry Hole) Dry Hole  
Date well completed 6-25 19 62  
Application for plugging filed 5-2 19 63  
Application for plugging approved 5-3 19 63  
Plugging commenced 5-6 19 63  
Plugging completed 5-9 19 63  
Reason for abandonment of well or producing formation Dry Hole

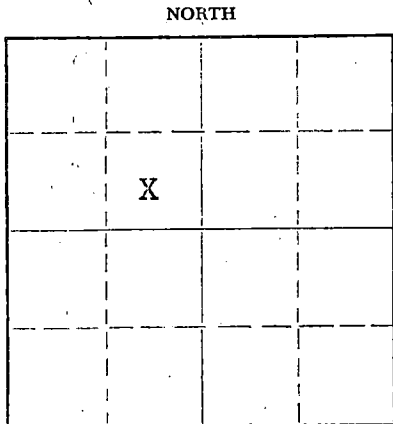

Locate well correctly on above Section Plat

If a producing well is abandoned, date of last production - 19  
Was permission obtained from the Conservation Division or its agents before plugging was commenced? Yes

Name of Conservation Agent who supervised plugging of this well A. Elving  
Producing formation None Depth to top - Bottom - Total Depth of Well 5981 Feet  
Show depth and thickness of all water, oil and gas formations.

OIL, GAS OR WATER RECORDS

CASING RECORD

FORMATION	CONTENT	FROM	TO	SIZE	PUT IN	PULLED OUT
Mississippian	Water	5123	5140	21"	38	None
				8 5/8"	570	None
				4 1/2"	5200	4050 ft.

Describe in detail the manner in which the well was plugged, indicating where the mud fluid was placed and the method or methods used in introducing it into the hole. If cement or other plugs were used, state the character of same and depth placed, from \_\_\_\_\_ feet to \_\_\_\_\_ feet for each plug set.

Pumped in 10 sacks cement from 5981' to 5100'.  
Heavy mud from 5100' to 250'.  
Rock Bridge from 250' to 240'.  
Pumped in 20 sacks cement from 250' to 174'.  
Heavy mud from 174' to 40'.  
Rock Bridge from 40' to 30'.  
Pumped in 10 sacks cement from 30' to surface.  
Welded cap on top of 8 5/8" casing.

RECEIVED  
STATE CORPORATION COMMISSION

MAY 21 1963

5-21-63  
CONSERVATION DIVISION  
Wichita, Kansas

(If additional description is necessary, use BACK of this sheet)

Name of Plugging Contractor: Ashland Oil & Refining Company  
Address: P. O. Box 949, Liberal, Kansas

STATE OF KANSAS, COUNTY OF SEWARD, ss.  
J. L. Jenkins

(employee of owner) or (owner) of the above-described well, being first duly sworn on oath, says: That I have knowledge of the facts, statements, and matters herein contained and the log of the above-described well as filed and that the same are true and correct. So help me God.

(Signature)

Box 949, Liberal, Kansas  
(Address)

SUBSCRIBED AND SWORN TO before me this 17th day of May, 19 63

My commission expires 6-6-66

Notary Public.

