

STATE OF KANSAS
STATE CORPORATION COMMISSION


WELL PLUGGING RECORD

Give All Information Completely
Make Required Affidavit
Mail or Deliver Report to:
Conservation Division
State Corporation Commission
800 Bitting Building
Wichita, Kansas

Comanche County, Sec. 4 Twp. 32 Rge. 16 (E) 16 (W)

Location as "NE/CNW/SW" or footage from lines SE SE SE
Lease Owner Rupp-Ferguson Oil Co.
Lease Name Price Well No. 1
Office Address 523 Petroleum Bldg., Wichita, Kansas
Character of Well (completed as Oil, Gas or Dry Hole) Dry Hole
Date well completed 6-27-55 19
Application for plugging filed 6-27-55 19
Application for plugging approved 6-27-55 19
Plugging commenced 6-27-55 19
Plugging completed 6-27-55 19
Reason for abandonment of well or producing formation

NORTH

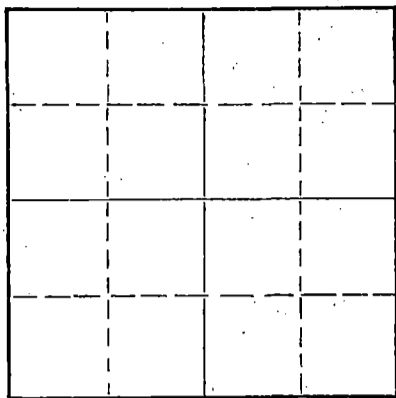

Locate well correctly on above Section Plat

If a producing well is abandoned, date of last production 19
Was permission obtained from the Conservation Division or its agents before plugging was commenced? Yes

Name of Conservation Agent who supervised plugging of this well M. A. Rives
Producing formation Depth to top Bottom Total Depth of Well 4943 Feet
Show depth and thickness of all water, oil and gas formations.

OIL, GAS OR WATER RECORDS

CASING RECORD

FORMATION	CONTENT	FROM	TO	SIZE	PUT IN	PULLED OUT

Describe in detail the manner in which the well was plugged, indicating where the mud fluid was placed and the method or methods used in introducing it into the hole. If cement or other plugs were used, state the character of same and depth placed, from feet to feet for each plug set.

Mud to 280', hulls, plug, 30 sacks cement thru drill pipe. Mud to 20 ft., plug tied, 1 sack hulls, 15 sacks cement.

(This was an old well workover originally drilled by Wentworth & Sons and plugged in October, 1951).

(If additional description is necessary, use BACK of this sheet)

Name of Plugging Contractor Rupp-Ferguson Oil Co.
Address 523 Petroleum Bldg., Wichita, Kansas

STATE OF Kansas, COUNTY OF Sedgwick, ss.
L. W. Knox (employee of owner) ~~an owner or operator~~ of the above-described well, being first duly sworn on oath, says: That I have knowledge of the facts, statements, and matters herein contained and the log of the above-described well as filed and that the same are true and correct. So help me God.

(Signature) L. W. Knox
523 Petroleum Bldg., Wichita, Kansas (Address)

SUBSCRIBED AND SWORN TO before me this 29th day of June, 19 55

My commission expires 6-4-59

Helen Horine Notary Public.
RECEIVED
STATE CORPORATION COMMISSION
JUN 30 1955
6-30-55
CONSERVATION DIVISION
Wichita, Kansas

PLUGGING
FILE SEC 10-32-16-00
130
PAGE 22 LINK 76