


15-033-30005-00-00

Give All Information Completely  
Make Required Affidavit  
Mail or Deliver Report to:  
Conservation Division  
State Corporation Commission  
211 No. Broadway  
Wichita, Kansas

WELL PLUGGING RECORD

COMANCHE County. Sec. 17 Twp. 32S Rge. (E) 18 (W)

Location as "NE/CNW\*SW\*" or footage from lines. C NW SE  
Lease Owner MAGAW & ZIMMER  
Lease Name HERD UNIT Well No. 1  
Office Address 22 PARK AVE. BLDG. SUITE 220 - OKLA. CITY, OKLA.  
Character of Well (completed as Oil, Gas or Dry Hole) DRY HOLE  
Date well completed 9-12- 19 65  
Application for plugging filed (PHONE 9-12-65) 9-17- 19 65  
Application for plugging approved (PHONE 9-12-65) 9-12- 19 65  
Plugging commenced 9-12- 19 65  
Plugging completed 9-12- 19 65  
Reason for abandonment of well or producing formation

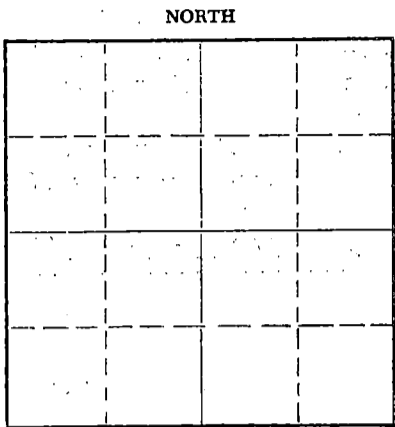

Locate well correctly on above Section Plat

If a producing well is abandoned, date of last production 19  
Was permission obtained from the Conservation Division or its agents before plugging was commenced? YES

Name of Conservation Agent who supervised plugging of this well HERMAN JUSTICE  
Producing formation Depth to top Bottom Total Depth of Well 5845 Feet  
Show depth and thickness of all water, oil and gas formations.

OIL, GAS OR WATER RECORDS

CASING RECORD

FORMATION	CONTENT	FROM	TO	SIZE	PUT IN	PULLED OUT
		0	588	8-5/8"	588'	NONE

Describe in detail the manner in which the well was plugged, indicating where the mud fluid was placed and the method or methods used in introducing it into the hole. If cement or other plugs were used, state the character of same and depth placed, from feet to feet for each plug set.

FILLED HOLE WITH HEAVY MUD TO 540 FEET. SET FIRST PLUG AT 540 FEET WITH 1/2 SACK HULLS AND 25 SACKS CEMENT. FILLED HOLE WITH HEAVY MUD TO 40 FEET. SET SECOND PLUG AT 40 FEET WITH 1/2 SACK HULLS AND 10 SACKS CEMENT. CEMENT FILLED TO TOP OF SURFACE PIPE. PUT 2 SACKS CEMENT EACH IN RAT HOLE AND MOUSE HOLE.

RECEIVED  
STATE CORPORATION COMMISSION

SEP 22 1965  
09-22-1965  
CONSERVATION DIVISION  
Wichita, Kansas

(If additional description is necessary, use BACK of this sheet)

Name of Plugging Contractor GABBERT-JONES, INC.  
Address 514 ORPHEUM BLDG., WICHITA, KANSAS

STATE OF KANSAS, COUNTY OF SEDGWICK, ss.  
E. E. HALL (employee of owner) or (owner or operator) of the above-described

well, being first duly sworn on oath, says: That I have knowledge of the facts, statements, and matters herein contained and the log of the above-described well as filed and that the same are true and correct. So help me God.

(Signature) *E. E. Hall*  
514 ORPHEUM BLDG., WICHITA, KANSAS  
(Address)

SUBSCRIBED AND SWORN TO before me this 17th day of SEPTEMBER 19 65

My commission expires FEBRUARY 1, 1968

*Barbara J. Layton*  
BARBARA J. LAYTON Notary Public.

15-033-30005-00-00

GABBERT-JONES, INC.  
WICHITA, KANSAS  
DRILLERS' WELL LOG

HERD UNIT #1  
NW SE SECTION 17-32S-18W  
COMANCHE COUNTY, KANSAS

COMMENCED: AUGUST 22, 1965  
COMPLETED: SEPTEMBER 12, 1965

OPERATOR - MAGAW & ZIMMER

DEPTH		FORMATION	REMARKS
From	To		
0	235	SAND	
235	588	RED BED	RAN 22 JOINTS 8-5/8" CSG., SET @ 574' w/150 SX. CEMENT
588	1150	RED BED AND SHALE	
1150	1650	SHALE	
1650	1948	SHALE AND SHELLS	
1948	2874	LIME AND SHALE	
2874	2975	LIME	
2975	3610	LIME AND SHALE	
3610	3695	SHALE	
3695	4210	SHALE AND LIME	
4210	4420	SHALE	
4420	4540	SHALE AND LIME	
4540	5110	LIME	
5110	5250	LIME AND SHALE	
5250	5660	LIME	
5660	5725	SHALE AND LIME	
5725	5845	LIME	
5845	TD		DRY AND ABANDONED.

RECEIVED  
STATE CORPORATION COMMISSION

SEP 22 1965  
09-22-1965  
CONSERVATION DIVISION  
Wichita, Kansas


I, E. E. HALL, CERTIFY THIS IS A CORRECT COPY OF THE DRILLERS' LOG FOR THE WELL DRILLED IN THE NW SE SECTION 17-32S-18W, COMANCHE COUNTY, KANSAS, TO THE BEST OF MY KNOWLEDGE AND BELIEF.

  
E. E. HALL

STATE OF KANSAS )  
                          ) SS  
COUNTY OF SEDGWICK )

BEFORE ME, THE UNDERSIGNED, A NOTARY PUBLIC WITHIN AND FOR SAID COUNTY AND STATE, ON THIS 15TH DAY OF SEPTEMBER, 1965, PERSONALLY APPEARED E. E. HALL, TO ME PERSONALLY KNOWN TO BE THE IDENTICAL PERSON WHO EXECUTED THE WITHIN AND FOREGOING INSTRUMENT AND ACKNOWLEDGED TO ME THAT HE EXECUTED THE SAME AS HIS FREE AND VOLUNTARY ACT AND DEED FOR THE USES AND PURPOSES THEREIN SET FORTH.

IN WITNESS WHEREOF, I HAVE HEREUNTO SET MY HAND AND OFFICIAL SEAL THE DAY AND YEAR LAST ABOVE WRITTEN.

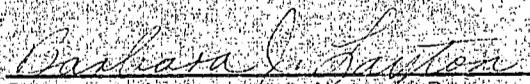  
BARBARA J. LAYTON, NOTARY PUBLIC

MY COMMISSION EXPIRES FEBRUARY 1, 1968.