


WELL PLUGGING RECORD

Give All Information Completely
Make Required Affidavit
Mail or Deliver Report to:
Conservation Division
State Corporation Commission
211 No. Broadway
Wichita, Kansas

NORTH

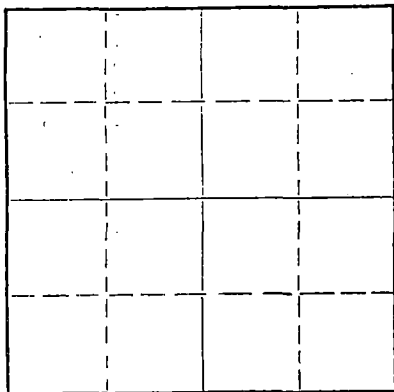

Locate well correctly on above
Section Plat

Comanche County. Sec. 28 Twp. 32 Rge. 19W (E) (W)
Location as "NE/CNW/SW" or footage from lines C SW SW
Lease Owner D. G. Hamilton
Lease Name Bird-Howard Well No. 1
Office Address 1001 Union Center, Wichita, Kansas
Character of Well (completed as Oil, Gas or Dry Hole) D&A
Date well completed November 20 1962
Application for plugging filed November 20 1962
Application for plugging approved November 20 1962
Plugging commenced November 20 1962
Plugging completed November 20 1962
Reason for abandonment of well or producing formation D&A

If a producing well is abandoned, date of last production 19
Was permission obtained from the Conservation Division or its agents before plugging was commenced? Yes

Name of Conservation Agent who supervised plugging of this well W. L. Lackamp
Producing formation _____ Depth to top _____ Bottom _____ Total Depth of Well 5275 Feet
Show depth and thickness of all water, oil and gas formations.

OIL, GAS OR WATER RECORDS

CASING RECORD

FORMATION	CONTENT	FROM	TO	SIZE	PUT IN	PULLED OUT
				8 5/8"	532.26	--0--

Describe in detail the manner in which the well was plugged, indicating where the mud fluid was placed and the method or methods used in introducing it into the hole. If cement or other plugs were used, state the character of same and depth placed, from _____ feet to _____ feet for each plug set.

Plug hole with heavy mud to 500'
set plug 1/2 sx hulls, 35 sx cement
filled hole to 40' 1/2 sx hulls on
plug - 15 sx cement.

RECEIVED
STATE CORPORATION COMMISSION
DEC 17 1962
12-17-62
CONSERVATION DIVISION
Wichita, Kansas

(If additional description is necessary, use BACK of this sheet)
Name of Plugging Contractor Red Tiger Drilling
Address Box 173--Russell, Kansas

STATE OF KANSAS, COUNTY OF SEDGWICK, ss.
George A. Angle (Employee or owner) or (owner or operator) of the above-described well, being first duly sworn on oath, says: That I have knowledge of the facts, statements, and matters herein contained and the log of the above-described well as filed and that the same are true and correct. So help me God.

(Signature) George A. Angle
580 Fourth Natl. Bank, Wichita, Kansas
(Address)

SUBSCRIBED AND SWORN to before me this 27th day of November, 1962

My commission expires 11-17-66
Doraine V. Head Notary Public.



DRILLERS LOG

Bird-Howard No. 1

CASING RECORD: 8 5/8" @ 532.26' w/400 sx cement
 COMPANY: D. G. Hamilton
 CONTRACTOR: Red Tiger Drilling Co.
 COMMENCED: November 1, 1962
 COMPLETED: November 20, 1962

DESCRIPTION: C SW SW
 28-32S-19W
 Comanche Co.,
 Kansas

ELEVATION: 1900 GR
 1905 RB

TOTAL DEPTH: 5275'

<u>FORMATION</u>	<u>FROM</u>	<u>TO</u>	<u>REMARKS</u>
Sand	0	20	
Red Bed & Sand	20	107	
Red Bed & Shells	107	680	
Anhydrite	680	700	
Shale & Shells	700	1935	
Shale & Lime Shells	1935	2100	
Lime & Shale	2100	4365	
Lime	4365	4795	
Lime & Shale	4795	4960	
Lime	4960	5275	

I certify that this is a true and correct copy of the above log to the best of my knowledge.

RED TIGER DRILLING COMPANY

George A. Angle
 George A. Angle

Subscribed and sworn to before me this 27th day of November, 1962.

Margie V. Head
 Notary Public

My Commission Expires:

11-17-66

RECEIVED
 STATE CORPORATION COMMISSION
 DEC 17 1962
 12-17-62
 CONSERVATION DIVISION
 Wichita, Kansas