


Give All Information Completely
Make Required Affidavit
Mail or Deliver Report to:
Conservation Division
State Corporation Commission
211 No. Broadway
Wichita, Kansas

WELL PLUGGING RECORD

Comanche County, Sec. 24 Twp. 32 Rge. 19 (E) W (W)

Location as "NE/CNW%SW%" or footage from lines NW SE NW
Lease Owner Olson Oil Company
Lease Name Morton Well No. 1
Office Address Tulsa, Oklahoma
Character of Well (completed as Oil, Gas or Dry Hole) Dry
Date well completed ~~4-3-62~~ 12-29-63 19
Application for plugging filed ~~12-28-63~~ 2-10-64 19
Application for plugging approved 2-11-64 19
Plugging commenced 2-12-64 19
Plugging completed 2-15-64 19
Reason for abandonment of well or producing formation Depleted.

NORTH

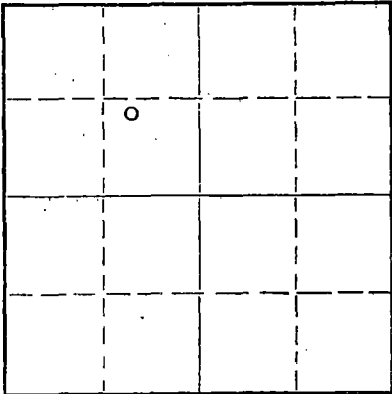

Locate well correctly on above Section Plat

If a producing well is abandoned, date of last production _____ 19
Was permission obtained from the Conservation Division or its agents before plugging was commenced? Yes

Name of Conservation Agent who supervised plugging of this well Archie Elving
Producing formation _____ Depth to top _____ Bottom _____ Total Depth of Well 6182' Feet
Show depth and thickness of all water, oil and gas formations.

OIL, GAS OR WATER RECORDS

CASING RECORD

FORMATION	CONTENT	FROM	TO	SIZE	PUT IN	PULLED OUT
				8-5/8"	484'	None
				5-1/2"	5297'	3234'

Describe in detail the manner in which the well was plugged, indicating where the mud fluid was placed and the method or methods used in introducing it into the hole. If cement or other plugs were used, state the character of same and depth placed, from _____ feet to _____ feet for each plug set.

Checked hole to plug back @ 4575', sanded hole to 4500' and dumped 5 sacks of cement @ 4500' with dump bailer. Pulled 5 1/2" casing, Mudded hole to 300', set rock bridge to 290' and dumped 30 sacks of cement @ 290' with dump bailer. Mudded hole to 40', and ran 15 sacks of cement to base of cellar.

RECEIVED
STATE CORPORATION COMMISSION

PLUGGING COMPLETE.

FEB 25 1964
2-25-64

CONSERVATION DIVISION
Wichita, Kansas

(If additional description is necessary, use BACK of this sheet)
Name of Plugging Contractor KNIGHT CASING PULLING COMPANY
Address CHASE, KANSAS

STATE OF KANSAS, COUNTY OF RICE, ss.
Noel J. Knight (employee of owner) or (owner) of the above-described well, being first duly sworn on oath, says: That I have knowledge of the facts, statements, and matters herein contained and the log of the above-described well as filed and that the same are true and correct. So help me God.

(Signature) Noel J. Knight
Chase, Kansas
(Address)

SUBSCRIBED AND SWORN TO before me this 17th day of February, 1964

My commission expires May 20, 1964 Milton J. Tolin Notary Public.