

15-033-00078-0000


STATE OF KANSAS
STATE CORPORATION COMMISSION

WELL PLUGGING RECORD

Give All Information Completely
Make Required Affidavit
Mail or Deliver Report to:
Conservation Division
State Corporation Commission
211 No. Broadway
Wichita, Kansas

Comanche County, Sec. 24 Twp. 32S Rge. 19W (E) (W)

NORTH

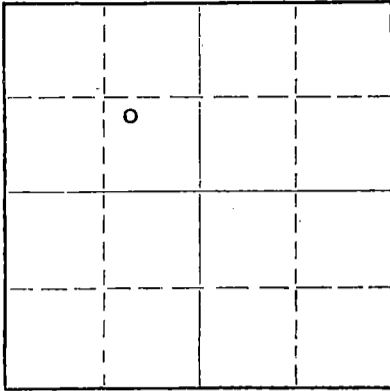

Locate well correctly on above
Section Plat

Location as "NE/CNW%SW%" or footage from lines NW SE NW
Lease Owner Olson Oil Company
Lease Name Jessie Marie Morton Well No. 1
Office Address Box 2680, Tulsa 1, Oklahoma
Character of Well (completed as Oil, Gas or Dry Hole) Dry Hole
Date well completed April 3 19 62
Application for plugging filed do 19
Application for plugging approved do 19
Plugging commenced do 19
Plugging completed do 19
Reason for abandonment of well or producing formation Dry Hole
If a producing well is abandoned, date of last production 19
Was permission obtained from the Conservation Division or its agents before plugging was commenced?

Name of Conservation Agent who supervised plugging of this well Fred W. Hampel, Pretty Prairie, Kansas
Producing formation _____ Depth to top _____ Bottom _____ Total Depth of Well 6180 Feet
Show depth and thickness of all water, oil and gas formations.

OIL, GAS OR WATER RECORDS

CASING RECORD

FORMATION	CONTENT	FROM	TO	SIZE	PUT IN	PULLED OUT
				10-3/4"	472'	None

Describe in detail the manner in which the well was plugged, indicating where the mud fluid was placed and the method or methods used in introducing it into the hole. If cement or other plugs were used, state the character of same and depth placed, from _____ feet to _____ feet for each plug set.

Set bridge plug at 470' - 35 sacks cement on plug. Filled w/ heavy mud to 40' from surface. Set bridge. 15 sacks cement up to bottom of cellar.

RECEIVED
STATE CORPORATION COMMISSION
MAY 3 1962
5-3-62
CONSERVATION DIVISION
Wichita, Kansas

(If additional description is necessary, use BACK of this sheet)

Name of Plugging Contractor Patton Drilling Company, Inc.
Address Wichita, Kansas

STATE OF OKLAHOMA, COUNTY OF TULSA, ss.
A. O. OLSON, OWNER (employee of owner) or (owner or operator) of the above-described well, being first duly sworn on oath, says: That I have knowledge of the facts, statements, and matters herein contained and the log of the above-described well as filed and that the same are true and correct. So help me God.

(Signature) A. O. Olson
Box 2680, Tulsa 1, Oklahoma
(Address)

SUBSCRIBED AND SWORN TO before me this 2nd day of May, 19 62

My commission expires March 26, 1965

Ann Whitten
Ann Whitten, Notary Public.



OLSON OIL COMPANY

MORTON WELL No.1

Total Depth

6180 ft.

Commenced

3/6/62

Rotary Completed D&A

4/3/62

Contractor: Patton Drilling Co., Inc.

Location: CNW/4-SE/4-NW/4 of
Sec.24-32S-19W., Comanche County, Ks.
CASING RECORD:

472 ft.10-3/4" casing at 484 ft.
Cemented with 300 sacks cement.

Sand & Clay	0-185
Red Shale & Shells	350
Red Bed & Shells	538
Red Bed, Shale & Shells	1355
Shale & Shells	1738
Shale & Shells	1983
Shale & Shells	2275
Lime & Shale	2365
Lime & Shale	2439
Lime & Shale	2546
Lime	2628
Lime	2705
Lime	2780
Lime & Shale	2845
Lime & Shale	2907
Lime & Shale	3035
Lime & Shale	3160
Lime & Shale	3198
Lime & Shale	3350
Lime & Shale	3367
Lime & Shale	3420
Lime & Shale	3505
Lime & Shale	3600
Lime & Shale	3706
Lime & Shale	3810
Lime & Shale	3870
Lime & Sandy Shale	3960
Lime & Shale	4070
Sandy Shale & Lime	4185
Sandy Lime & Shale	4224
Lime & Shale	4342
Sandy Shale & Lime	4460
Lime	4499
Lime	4579
Lime	4632
Lime	4684
Lime	4756
Lime	4784
Lime	4825
Lime & Shale	4852
Lime & Shale	4911
Lime	4963
Lime	4969
Lime	5007
Lime	5083
Lime & Shale	5120
Lime	5168
Lime & Shale	5200
Lime	5240
Cherty Lime	5270
Lime	5313
Cherty Lime	5378
Lime (Miss.)	5423
Lime	5495
Lime	5540
Lime	5588
Lime & Shale	5655
Lime & Shale	5676
Lime & Shale	5740
Lime & Shale	5773
Lime	5802
Lime	5878
Lime	5907
Lime	5973
Lime & Shale	6016
Sandy Shale & Lime	6050
Lime	6084
Lime	6170
Lime (Arbuckle)	6180

TOPS:
All measurements from Kelly Bushing
11 ft. above ground level.

Brown Lime	4453'
Lansing-Kansas City	4490'
Marmaton	4994'
Cherokee	5090'
Mississippian Lime	5144'
Kinderhook Shale	5667'
Viola Limestone	5742'
Simpson Dolomite	5906'
Arbuckle Dolomite	6029'

RECEIVED
STATE CORPORATION COMMISSION
MAY 3 1962
5-3-62
CONSERVATION DIVISION
Wichita, Kansas

Page 2. Sample Log. Olson Oil Co.'s. Well No.1-Morton

STATE OF KANSAS: COUNTY OF SEDGWICK: SS.

I, the underigned, being duly sworn, on oath state that the above statement and log is a true and correct record and log of the well drilled at the location above described on page 1 hereof.

PATTON DRILLING COMPANY, INC.,

By R. C. Patton
President

Subscribed and sworn to before me this 10th day of April, 1962.

Myrtle A. Suit
Notary Public
(Myrtle A. Suit)

My Commission Expires: March 12, 1964

(seal)

RECEIVED
STATE CORPORATION COMMISSION
MAY 3 1962
53-62
CONSERVATION DIVISION
Wichita, Kansas