


Give All Information Completely
Make Required Affidavit
Mail or Deliver Report to:
Conservation Division
State Corporation Commission
212 No. Market
Wichita, Kansas

WELL PLUGGING RECORD

Comanche County. Sec. 20 Twp. 33S Rge. (E) 16 (W)

Location as "NE/CNW/SW" or footage from lines NW SW
Lease Owner Mull Drilling Company, Inc.
Lease Name GREGG, GREGG & BOOTH Well No. 1
Office Address 1625 Wichita Plaza - Wichita, Kansas
Character of Well (completed as Oil, Gas or Dry Hole) Dry Hole
Date well completed 6-22 19 68
Application for plugging filed 6-22 19 68
Application for plugging approved 6-22 19 68
Plugging commenced 6-22 19 68
Plugging completed 8:30 P.M. 6-22 19 68
Reason for abandonment of well or producing formation No oil or gas found in commercial quantities.
If a producing well is abandoned, date of last production 19
Was permission obtained from the Conservation Division or its agents before plugging was commenced? Yes

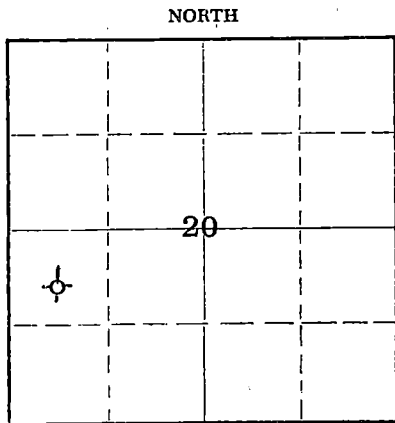

Locate well correctly on above Section Plat

Name of Conservation Agent who supervised plugging of this well Ralph Warren, Pratt, Kansas
Producing formation None Depth to top Bottom Total Depth of Well 5069 Feet
Show depth and thickness of all water, oil and gas formations.

OIL, GAS OR WATER RECORDS

CASING RECORD

FORMATION	CONTENT	FROM	TO	SIZE	PUT IN	PULLED OUT
		STATE CORPORATION COMMISSION		8-5/8"	291'	-0-
		RECEIVED				
		JUN 28 1968				
		CONSERVATION DIVISION				
		Wichita, Kansas				

Describe in detail the manner in which the well was plugged, indicating where the mud fluid was placed and the method or methods used in introducing it into the hole. If cement or other plugs were used, state the character of same and depth placed, from feet to feet for each plug set.

Mud back to 250'. Set solid bridge and cement with 25 sacks cement. Mud back to 40'. Set solid bridge and capped with 10 sacks, 2 sacks in rat hole. Plugging completed at 8:30 PM, 6-22-68.

(If additional description is necessary, use BACK of this sheet)

Name of Plugging Contractor Rains & Williamson Oil Co., Inc.
Address 1425 Wichita Plaza - Wichita, Kansas

STATE OF KANSAS, COUNTY OF SEDGWICK, ss.
Wilson Rains (employee of owner) or (owner or operator) of the above-described well, being first duly sworn on oath, says: That I have knowledge of the facts, statements, and matters herein contained and the log of the above-described well as filed and that the same are true and correct. So help me God.

(Signature) Wilson Rains
Wilson Rains
1425 Wichita Plaza - Wichita, Kansas
(Address)

SUBSCRIBED AND SWORN TO before me this 26 day of June 19 68

My commission expires June 30, 1971
Sherry Gish
Notary Public.

ROTARY DRILLING LOG

Operator: Mull Drilling Company, Inc.
GREGG, GREGG and BOOTH #1
NW SW Section 20-33S-16W
Comanche County, Kansas

Contractor: Rains & Williamson
Oil Co., Inc.
Commenced: 6-10-68
Completed: 6-22-68

Remarks: Set 8-5/8" surface casing at 291' w/ 200 sacks GL-3 cmt.

Formations

Red Bed	291'
Shale	1770'
Lime and Shale	2340'
Lime	2775'
Lime and Shale	3120'
Shale and Lime	3300'
Lime and Shale	3595'
Shale and Lime	3900'
Lime and Shale	4165'
Shale and Lime	4325'
Lime and Shale	4376'
Lime	5030'
Lime and Chert	5069'
Rotary Total Depth (D & A)	5069'

RECEIVED
STATE CORPORATION COMMISSION
JUN 28 1968
CONSERVATION DIVISION
Wichita, Kansas


We certify the above log is true and correct to the best of our knowledge and belief.

RAINS & WILLIAMSON OIL CO., INC.



Wilson Rains

Subscribed and sworn to before me, a Notary Public within and for the State of Kansas, County of Sedgwick, this 26th day of June, 1968.

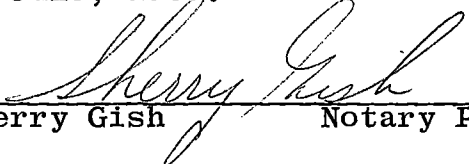

Sherry Gish Notary Public

My Commission Expires:
June 30, 1971