


15-151-10884-00-00

STATE OF KANSAS  
STATE CORPORATION COMMISSION

Give All Information Completely  
Make Required Affidavit  
Mail or Deliver Report to:  
Conservation Division  
State Corporation Commission  
800 Bitting Building  
Wichita, Kansas

WELL PLUGGING RECORD

Pratt County. Sec. 36 Twp. 26 Rge. 13 (N) (W)  
Location as "NE/CNW/SW" or footage from lines NE/4 SW/4 SE/4  
Lease Owner McKnab Drilling, Inc.  
Lease Name Wm Beck Well No. 1  
Office Address 503 Union National Bank Bldg., Wichita, Kansas  
Character of Well (completed as Oil, Gas or Dry Hole) Dry Hole  
Date well completed October 11 1955  
Application for plugging filed October 11 1955  
Application for plugging approved October 11 1955  
Plugging commenced October 12 1955  
Plugging completed October 12 1955  
Reason for abandonment of well or producing formation Dry Hole

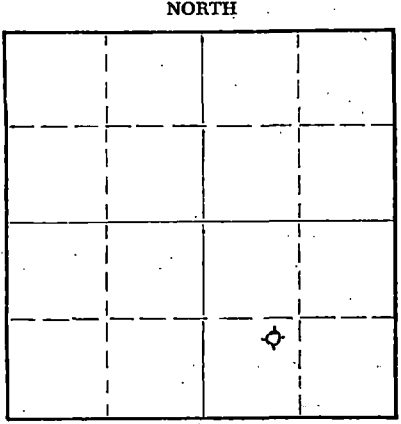

Locate well correctly on above Section Plat

If a producing well is abandoned, date of last production 19  
Was permission obtained from the Conservation Division or its agents before plugging was commenced? Yes

Name of Conservation Agent who supervised plugging of this well Merle Rives  
Producing formation Depth to top Bottom Total Depth of Well 4350 Feet  
Show depth and thickness of all water, oil and gas formations.

OIL, GAS OR WATER RECORDS

CASING RECORD

FORMATION	CONTENT	FROM	TO	SIZE	PUT IN	PULLED OUT
Red Bed	Surface Pipe	0	441'	8 5/8"	9-27-55	

Describe in detail the manner in which the well was plugged, indicating where the mud fluid was placed and the method or methods used in introducing it into the hole. If cement or other plugs were used, state the character of same and depth placed, from feet to feet for each plug set.

Gunned up pits to get heavy mud - circulated till we had returns in sample box -  
laid down drill pipe - filled hole with mud to 300' - set HOWCO top plug with 1/4  
sack of hulls rolled in sack - mixed 20 sacks cement in barrell and poured through 10  
joints drill pipe on top of plug - filled hole with mud to 35' set HOWCO Top plug and  
1/3 sack hulls - mixed 10 sacks cement on top of plug to bottom of cellar and tied  
top plug with wire line.

(If additional description is necessary, use BACK of this sheet)

Name of Plugging Contractor  
Address

STATE OF KANSAS, COUNTY OF SEDGWICK, ss.  
Don Gardner (employee of owner) or (owner or operator) of the above-described well, being first duly sworn on oath, says: That I have knowledge of the facts, statements, and matters herein contained and the log of the above-described well as filed and that the same are true and correct. So help me God.

(Signature) [Signature]  
503 Union National Bank Building  
(Address)

SUBSCRIBED AND SWORN TO before me this 18th day of October, 1955

My commission expires November 21, 1956

RECEIVED  
STATE CORPORATION COMMISSION  
OCT 22 1955  
10-22-55  
CONSERVATION DIVISION  
Wichita, Kansas  
Notary Public. [Signature]

PLUGGING  
FILE SEC 36 T 26 R 13 W  
BOOK PAGE 8 LINE 9

15-151-10884-00-00

D R I L L E R ' S L O G

McKnab Drilling, Inc.  
Beck A #1  
NE SW SE 36-26-13W  
Pratt County, Kansas

<u>TO</u>	<u>FROM</u>	
0	275	Sand
275	600	Red Bed & Shale
600	1740	Shale & Shells
1740	2430	Shale & Lime
2430	2860	Lime & Shale
2860	3015	Shale & Shells
3015	3219	Shale & Lime
3219	3503	Lime & Shale
3503	3612	Lime
3612	3765	Lime & Shale
3765	4035	Lime
4035	4077	Lime & Shale
4077	4128	Shale & Lime
4128	4137	Shale, Chert & Lime
4137	4166	Chert
4166	4252	Chert & Lime
4252	4265	Chert & Sand
4265	4283	Sand & Chert
4283	4331	Shale
4331	4350	Lime
	4350	ROTARY TOTAL DEPTH
		<u>D &amp; A</u>

COMMENCED: 9-25-55  
COMPLETED: 10-12-55

CASING RECORD

Set 441'8" of 8 5/8 " surface casing with 290 sacks of cement, 1% c.c. and 1% jel.


STATE OF KANSAS )  
                          ) SS  
COUNTY OF SEDGWICK )

I hereby affirm that the above and foregoing is a true and correct copy of the log of the Beck A #1 located in the NE/4 SW/4 SE/4 of Section 36, Township 26 South, Range 13 West, Pratt County, Kansas.

McKNAB DRILLING, INC.

  
Don Gardner

Subscribed and sworn to before me this 17th day of October 1955.

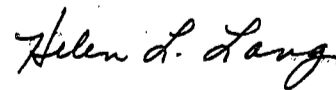  
Notary Public

My Commission Expires November 21, 1956.

RECEIVED  
STATE CORPORATION COMMISSION  
OCT 22 1955  
10-22-55  
CONSERVATION DIVISION  
Wichita, Kansas

PLUGGING  
FILE SEC 36 T 26 R 13W  
BOOK PAGE 8 LINE 9