


15-151-10874-00-00

WELL PLUGGING RECORD

Give All Information Completely  
Make Required Affidavit  
Mail or Deliver Report to:  
Conservation Division  
State Corporation Commission  
800 Bitting Building  
Wichita, Kansas

NORTH

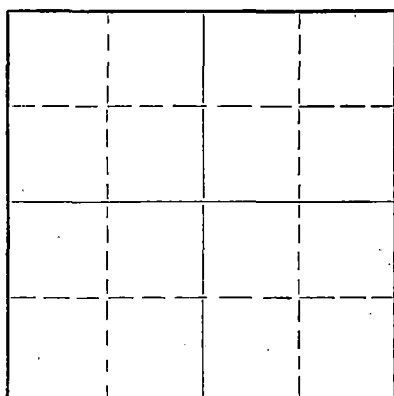

Locate well correctly on above  
Section Plat

Pratt County. Sec. 36 Twp. 26 Rge. (E) 13 (W)  
Location as "NE/CNW/SW" or footage from lines SE NE SW/4  
Lease Owner Peters, Writer & Christensen, Inc.  
Lease Name Beck Well No. 1  
Office Address 724 - 17th Street, Denver, Colorado  
Character of Well (completed as Oil, Gas or Dry Hole) dry  
Date well completed Nov. 28 19 52  
Application for plugging filed Nov. 28 19 52  
Application for plugging approved Nov. 28 19 52  
Plugging commenced Nov. 28 19 52  
Plugging completed Nov. 29 19 52  
Reason for abandonment of well or producing formation dry

If a producing well is abandoned, date of last production 19  
Was permission obtained from the Conservation Division or its agents before plugging was commenced? Yes

Name of Conservation Agent who supervised plugging of this well M. A. Rives  
Producing formation Depth to top Bottom Total Depth of Well 4366 Feet  
Show depth and thickness of all water, oil and gas formations.

OIL, GAS OR WATER RECORDS

CASING RECORD

FORMATION	CONTENT	FROM	TO	SIZE	PUT IN	PULLED OUT
				8-5/8"	489	None

Describe in detail the manner in which the well was plugged, indicating where the mud fluid was placed and the method or methods used in introducing it into the hole. If cement or other plugs were used, state the character of same and depth placed, from feet to feet for each plug set.

Filled hole with heavy Rotary mud to 300 ft.

Set plug and ran 20 sacks cement thru drill pipe.

Filled with mud to 35 ft., set plug and ran 10

sacks cement at the surface.

(If additional description is necessary, use BACK of this sheet)

Name of Plugging Contractor M. B. Arner  
Address 710 Petroleum Bldg., Wichita 2, Kansas

STATE OF Kansas, COUNTY OF Sedgwick ss.  
L. C. Sponenberg employee of contractor  
of the above-described well, being first duly sworn on oath, says: That I have knowledge of the facts, statements, and matters herein contained and the log of the above-described well as filed and that the same are true and correct. So help me God.

(Signature) *L. C. Sponenberg*  
(Address)

SUBSCRIBED AND SWORN TO before me this 3rd day of December, 19 52

My commission expires Sept. 17, 1955.

*Hazel Walton*  
Notary Public.

24-2675-S 2-52-20M  
**PLUGGING**  
FILE SEC 36 T 26 R 13 2  
BOOK PAGE 62 LINE 26

RECEIVED  
STATE CORPORATION COMMISSION  
12-5-52  
CONF. FILED IN RECORD  
WICHITA, KANSAS

15-151-10874-00-00

LOG

Company: Peters, Writer & Christensen, Inc.  
Contractor: M. B. Armer  
Drilling Commenced: 11/9/52  
Drilling Completed: 11/29/52  
Elevation: Est. 1923 D.F.  
" 1921 Gr.

Farm: Beck No. 1  
Location: SE NE SW/4  
Sec. 36-26S-13W  
Pratt County, Kans.  
Casing Record: 8-5/8" casing  
at 489'

(figures below indicate bottoms)

Surface Clay & Sand	230
Red Bed - Sticky Shale	300
Red Bed	340
Sand	385
Shale, Shells & Red Bed	530
Red Bed & Shale	780
Shale	830
Shale & Shells	1025
Red bed & Shale	1148
Shale & Lime	1400
Shale Shells & Salt	1750
Shale & Shells	1880
Sandy Lime & Shale	1995
Shale & Lime	3895
Lime	4127
Lime & Shale	4173
Cherty Lime	4220
Cherty Lime & Shale	4294
Shale & Lime	4366
R.T.D.	4366

I hereby certify that this is a true and correct log of the above described well as shown by the drilling reports.

M. B. ARMER

By *L. C. Spruery*

STATE OF KANSAS  
COUNTY OF SEDGWICK ss:

Subscribed and sworn to before me, a notary public, in and for said County and State this 3rd day of December, 1952.

**PLUGGING**  
FILE SEC 26 T 26 R 132  
BOOK PAGE 62 LINE 26

*L. C. Spruery*  
Notary Public

My Commission Expires: Sept. 17, 1955.

NOTARY PUBLIC

DEC 5 1952

NOTARY DIVISION  
Pratt, Kansas