


WELL PLUGGING RECORD

Give All Information Completely
Make Required Affidavit
Mail or Deliver Report to:
Conservation Division
State Corporation Commission
212 No. Market
Wichita, Kansas

Commanche County, Sec. 13 Twp. 33S Rge. (E) 16 (W)

Location as "NE/CNW/SE/SW" or footage from lines NE SW
Lease Owner Shenandoah Oil Corporation
Lease Name Merrill Ranch Well No. A-1
Office Address 1018 Commerce Building, Ft. Worth, Texas
Character of Well (completed as Oil, Gas or Dry Hole) Dry Hole
Date well completed 8-12 1968
Application for plugging filed 4-15 1969
Application for plugging approved 4-16 1969
Plugging commenced April 22, 1969
Plugging completed April 28, 1969
Reason for abandonment of well or producing formation Non-commercial

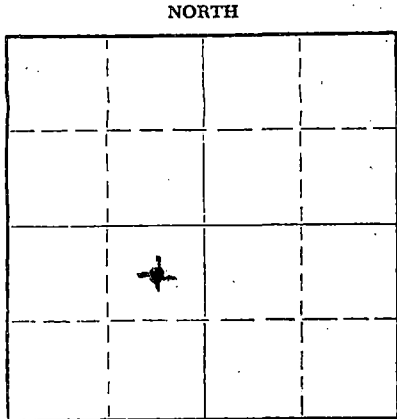

Locate well correctly on above Section Plat

If a producing well is abandoned, date of last production - 19 -
Was permission obtained from the Conservation Division or its agents before plugging was commenced? Yes

Name of Conservation Agent who supervised plugging of this well Mr. R. J. Warren
Producing formation Mississippi Depth to top 4840 Bottom 5182 Total Depth of Well 5625 Feet
Show depth and thickness of all water, oil and gas formations.

OIL, GAS OR WATER RECORDS

CASING RECORD

FORMATION	CONTENT	FROM	TO	SIZE	PUT IN	PULLED OUT
Arbuckle	Water	5486	5625	8-5/8"	412'	None
Simpson	Water	5464	5486	4-1/2"	5027'	4023.33'
Mississippi	Gas & wtr					

Describe in detail the manner in which the well was plugged, indicating where the mud fluid was placed and the method or methods used in introducing it into the hole. If cement or other plugs were used, state the character of same and depth placed, from feet to feet for each plug set.

A ten (10) sack cement plug was pumped to 4350 feet with mud laden fluid. Pipe was shot free at 4009 feet and pulled. Set chat bridge at 300 feet. Dumped two (2) yards of concrete on bridge. Put mud spacer to 30 feet of top. Finished filling with concrete.

RECEIVED
STATE CORPORATION COMMISSION
MAY 8 1969
CONSERVATION DIVISION
Wichita, Kansas

(If additional description is necessary, use BACK of this sheet)
Name of Plugging Contractor Clyde A. Reeves & Sons Inc.
Address Box 94204 Oklahoma City, Oklahoma

STATE OF Texas, COUNTY OF Tarrant, ss.
Harold E. Burke (employee of owner) or (owner) of the above-described well, being first duly sworn on oath, says: That I have knowledge of the facts, statements, and matters herein contained and the log of the above-described well as filed and that the same are true and correct. So help me God.

(Signature) Harold E. Burke
Ft Worth Texas (Address)

SUBSCRIBED AND SWORN TO before me this 7th day of May, 1969

My commission expires June 1, 1969

Jerry Robbins Notary Public.