


STATE OF KANSAS
STATE CORPORATION COMMISSION

Form CP-4

Give All Information Completely
Make Required Affidavit
Mail or Deliver Report to:
Conservation Division
State Corporation Commission
P. O. Box 17027
Wichita, Kansas 67217
NORTH

WELL PLUGGING RECORD

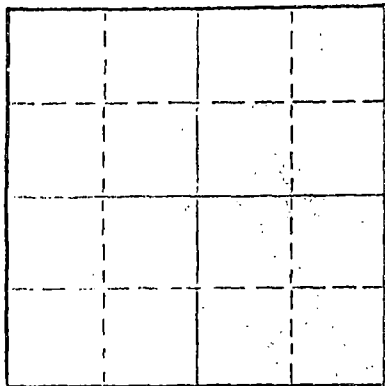

Locate well correctly on above
Section Plat

Gomanche County, Sec. 13 Twp. 33S. Rge. 16W (E) (W)
Location as "NE/CNWSW" or footage from lines C/SE-NE
Lease Owner Clarke Corporation
Lease Name Brass Well No. 1
Office Address Box 187, Medicine Lodge, Kan. 67104
Character of Well (completed as Oil, Gas or Dry Hole) Gas
Date well completed 5-20- 19 75
Application for plugging filed 4-10- 19 76
Application for plugging approved 4-12- 19 76
Plugging commenced 4-19- 19 76
Plugging completed 4-23- 19 76
Reason for abandonment of well or producing formation Not Productive

If a producing well is abandoned, date of last production 19
Was permission obtained from the Conservation Division or its agents before plugging was commenced? Yes

Name of Conservation Agent who supervised plugging of this well Russell Biberstien
Producing formation Depth to top Bottom Total Depth of Well 4769 Feet
Show depth and thickness of all water, oil and gas formations.

OIL, GAS OR WATER RECORDS

CASING RECORD

FORMATION	CONTENT	FROM	TO	SIZE	PUT IN	PULLED OUT
				8 5/8	270	None
				4 1/2	4760	3490

Describe in detail the manner in which the well was plugged, indicating where the mud fluid was placed and the method or methods used in introducing it into the hole. If cement or other plugs were used, state the character of same and depth placed, from feet to feet for each plug set.

Dumped sand and plugged off bottom
Sand from 6747 to 4470'

4 sacks cement from 4470 to 4430'

Built wooden bridge at 240'
Rock from 240 to 230'

25 sacks cement from 230 to 155'
Mud from 155 to 40'

Rock from 40 to 30'

10 sacks cement from 30 to top

RECEIVED
STATE CORPORATION COMMISSION
APR 20 1976
CONSERVATION DIVISION
Wichita, Kansas

Name of Plugging Contractor Clarke Corporation
Address Box 187, Medicine Lodge, Kansas 67104

STATE OF Kansas COUNTY OF Barber, ss.
Elmer R. Margenstern (employee of owner) or (owner or operator) of the above-described well, being first duly sworn on oath, says: That I have knowledge of the facts, statements, and matters herein contained and the log of the above-described well as filed and that the same are true and correct. So help me God.

(Signature) Elmer R. Margenstern

SUBSCRIBED AND SWORN TO before me this 27th day of April, 1976

My commission expires April 4, 1978
Jessie Hamilton Notary Public.