

STATE OF KANSAS  
STATE CORPORATION COMMISSION

WELL PLUGGING RECORD

Give All Information Completely  
Make Required Affidavit  
Mail or Deliver Report to  
Conservation Division  
State Corporation Comm.  
245 North Water  
Wichita, KS 67202

Comanche County, Sec. 13 Twp. 33S Rge. 16  W  
Location as "NE/CNW $\frac{1}{4}$ /SW $\frac{1}{4}$ " or footage from lines  
NE $\frac{1}{4}$


Lease Owner Roy D. McAninch  
Lease Name Beth Well No. 1  
Office Address Glenbrook Centre West; 1140 NW 63rd OKC 73116  
Character of Well (Completed as Oil, Gas or Dry Hole) \_\_\_\_\_  
Dry Hole

Date Well completed October 2 1979  
Application for plugging filed October 2 1979  
Application for plugging approved October 2 1979  
Plugging commenced October 2 1979  
Plugging completed October 2 1979  
Reason for abandonment of well or producing formation \_\_\_\_\_  
Dry Hole

If a producing well is abandoned, date of last production \_\_\_\_\_ 19\_\_\_\_

Was permission obtained from the Conservation Division or its agents before plugging was commenced? Yes \_\_\_\_\_

Name of Conservation Agent who supervised plugging of this well Bill Owens  
Producing formation \_\_\_\_\_ Depth to top \_\_\_\_\_ Bottom \_\_\_\_\_ Total Depth of Well 4850  
Show depth and thickness of all water, oil and gas formations.

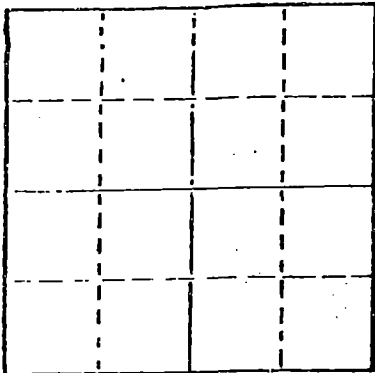

Locate well correctly on above Section Plat


OIL, GAS OR WATER RECORDS

CASING RECORD

FORMATION	CONTENT	FROM	TO	SIZE	PUT IN	PULLED OUT
				8 5/8	333'	-0-

Describe in detail the manner in which the well was plugged, indicating where the mud fluid was placed and the method or methods used in introducing it into the hold. If cement or other plugs were used, state the character of same and depth placed, from \_\_\_\_\_ feet to \_\_\_\_\_ feet for each plug set.

Plug Hole 40 sks @ 700'  
40 sks @ 330'  
125 sks @ 50'  
3 sks in rathole

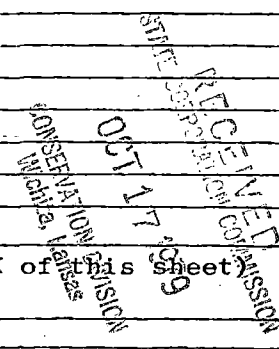

(If additional description is necessary, use BACK of this sheet)

Name of Plugging Contractor \_\_\_\_\_


STATE OF Kansas COUNTY OF Sedgwick, ss.  
Robert L. Eisel (employee of owner) or (owner or operator)  
of the above-described well, being first duly sworn on oath, says: That I have knowledge of the facts, statements, and matters herein contained and the log of the above-described well as filed and that the same are true and correct. So help me God.

(Signature) Robert L. Eisel  
Suite 210 260 N. Rock Road Wichita, KS 67206  
(Address)

SUBSCRIBED AND SWORN TO before me this 10th day of October, 1979

Sharon Winter  
Sharon Winter Notary Public.

My commission expires August 13, 1983

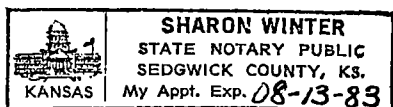



STATE OF KANSAS  
STATE CORPORATION COMMISSION - CONSERVATION DIVISION  
245 North Water  
Wichita, Kansas 67202

FORM C-2

DATA AND AFFIDAVIT

(On Cementing in Surface or Drive Pipe and required by Rule 82-2-123 of the Commission for compliance with Section 55-136, 55-137 and 55-138, 1947 Supplement to G. S. Kansas 1935)

LEASE OWNER Roy D. McAninch  
OFFICE ADDRESS Glenbrook Centre West 1140 N. W. 63rd St. Oklahoma City, OK 73116  
LEASE NAME Beth WELL NO. 1 COUNTY Comanche  
EXACT SPOT LOCATION NE 1/4 SEC. 13 TWP. 33 RGE. 16 (W)  
CONTRACTOR Eagle Drilling, Inc.  
OFFICE ADDRESS Suite 210 260 N. Rock Road Wichita, Kansas 67206

Drilled with (Cable) or (Rotary) tools: \_\_\_\_\_ Date pipe set \_\_\_\_\_

SURFACE HOLE DATA

SURFACE PIPE DATA

Size of Hole 12 1/4 Csg. (new) or (used) Size 8 5/8 Wt. \_\_\_\_\_  
Depth 333 ft. Where set 333 ft.

METHOD OF CEMENTING

Cement: Amount and kind 225 sks. Reg. 2% gel. 3% cc  
Method: (By Service Co., Dump, Tog., etc.) Service  
Est. Height Cement behind pipe Cement circulated to surface

GROUND WATER INFORMATION

Depth to bottom of lowest fresh water producing stratum \_\_\_\_\_  
Name of lowest fresh water producing stratum \_\_\_\_\_  
Surface elevation of well \_\_\_\_\_

ADDITIONAL INFORMATION

(Additional information may be submitted on separate sheet)

A F F I D A V I T

STATE OF Kansas, COUNTY OF Sedgwick SS,

I, Robert L. Eisel, of the Eagle Drilling, Inc. Company, being first duly sworn on oath, state: That I have knowledge of the facts, statements and matters herein contained and that the same are true and correct.

Robert L. Eisel  
Robert L. Eisel -- Vice-President

Subscribed and sworn to before me on this 10th day of October 19 79

My Commission Expires:  
August 13, 1983

Sharon Winter  
Notary Public Sharon Winter

