


15-033-20413-00-00

STATE OF KANSAS
STATE CORPORATION COMMISSION

WELL PLUGGING RECORD

Give All Information Completely
Make Required Affidavit
Mail or Deliver Report to
Conservation Division
State Corporation Comm.
245 North Water
Wichita, KS 67202

Commanche County, Sec. 8 Twp. 335 Rge. 16W E/W
Location as "NE/CNW $\frac{1}{4}$ SW $\frac{1}{4}$ " or footage from lines
2310 FNL, 2310 FWL
Lease Owner Texas Oil and Gas
Lease Name Gregg-Booth Well No. A-3
Office Address 200 W. Douglas, Suite 300, Wichita, Kansas 67202
Character of Well (Completed as Oil, Gas or Dry Hole)

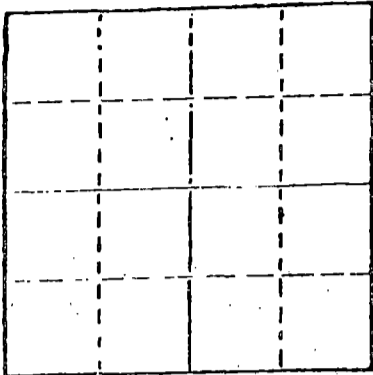

Locate well correctly on above
Section Plat

Gas
Date Well completed 3-10 19 81
Application for plugging filed 7-30 19 81
Application for plugging approved 8-1 19 81
Plugging commenced 8-22 19 81
Plugging completed 8-31 19 81
Reason for abandonment of well or producing formation
Not productive

If a producing well is abandoned, date of last production 19

Was permission obtained from the Conservation Division or its agents before plugging was commenced? yes

Name of Conservation Agent who supervised plugging of this well M. V. Leslie
Producing formation _____ Depth to top _____ Bottom _____ Total Depth of Well 5100
Show depth and thickness of all water, oil and gas formations.

OIL, GAS OR WATER RECORDS

CASING RECORD

FORMATION	CONTENT	FROM	TO	SIZE	PUT IN	PULLED OUT
				10 3/4	60	None
				8 5/8	989	None
				4 1/2	5099	4051

Describe in detail the manner in which the well was plugged, indicating where the mud fluid was placed and the method or methods used in introducing it into the hold. If cement or other plugs were used, state the character of same and depth placed, from _____ feet to _____ feet for each plug set.

C.I.B. at 4990
Sand from 4990 to 4860
4 sacks cement from 4860 to 4820
Ripped 4100 - 4050
Allied pumped in 15 - gel
8 - Hull
10 - gel
150 sacks 50-50 POZ, 4% gel, 3%CC

(If additional description is necessary, use BACK of this sheet)

Name of Plugging Contractor Clarke Corporation

STATE OF Kansas COUNTY OF Barber, ss.
Erma R. Margenstern (employee of owner) or (owner or operator)
of the above-described well, being first duly sworn on oath, says: That I have knowledge of the facts, statements, and matters herein contained and the log of the above-described well as filed and that the same are true and correct. So help me God.

(Signature) Erma R. Margenstern
Medicine Lodge, Ks.
(Address)

SUBSCRIBED AND SWORN TO before me this 31st day of August, 1981

Jessie Hamilton
Notary Public.

My commission expires April 4, 1982

RECEIVED
STATE CORPORATION COMMISSION
SEP - 2 1981
CONSERVATION DIVISION
Wichita, Kansas

KANSAS DRILLERS LOG

COMPANY Texas Oil & Gas Corp.

SEC. 8 T. 33S. 16W

FARM Gregg-Booth "A" NO. 3

LOC. 2310' FNL & 2310' FW

COUNTY Comanche

ROTARY TOTAL DEPTH 5,100'

COMM. February 16, 1981 COMP. February 26, 1981

CONTRACTOR FREEMAN DRILLING COMPANY (Rig No. 1)

ISSUED March 10, 1981

CASING

60' of 16" Conductor pipe cemented w/300 sxs cement
10 3/4"

8 5/8" Set at 989' cemented w/225 sxs cement

ELEVATION 1,857' K.B.

5 1/2"

4 1/2" Set at 5,099' cemented w/225 sxs cement

FIGURES INDICATE BOTTOM OF FORMATIONS

Red Bed and Sand	989'
Red Bed and Shale	1,710'
Shale	2,140'
Lime and Shale	2,561'
Shale	2,850'
Lime and Shale	5,100'
Rotary Total Depth	5,100'

I hereby certify the above and foregoing to be a true and correct log of the above described well as shown by the drilling reports.

FREEMAN DRILLING COMPANY, INC.

Dean Britting
Dean Britting

State of Kansas)
) SS:
County of Sedgwick)

Subscribed and Sworn to before me a Notary Public in and for said county and state this 10th day of March, 1981.

Elsie Willison
Elsie Willison - Notary Public

My Commission Expires:

July 25, 1982

RECEIVED
STATE CORPORATION COMMISSION

MAR 31 1981
CONSERVATION DIVISION
Wichita, Kansas