


STATE OF KANSAS
STATE CORPORATION COMMISSION

Form CP-4

WELL PLUGGING RECORD

Give All Information Completely
Make Required Affidavit
Mail or Deliver Report to:
Conservation Division
State Corporation Commission
212 No. Market
Wichita, Kansas

NORTH

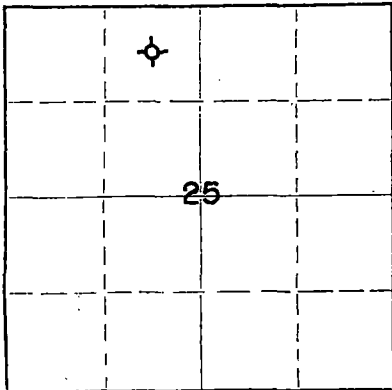

Locate well correctly on above
Section Plat

Comanche County, Sec. 25 Twp. 33S Rge. (E) 20 (W)
Location as "NE/CNW/SW" or footage from lines. C NE/4 NW/4
Lease Owner Midwest Oil Corporation
Lease Name Baker Well No. 2
Office Address 1418 Liberty Bank Building, Oklahoma City, Oklahoma
Character of Well (completed as Oil, Gas or Dry Hole) Dry Hole
Date well completed October 4, 19 70
Application for plugging filed Attached 19
Application for plugging approved October 4, 19 70
Plugging commenced October 4, 19 70
Plugging completed October 4, 19 70
Reason for abandonment of well or producing formation Dry Hole

If a producing well is abandoned, date of last production - 19
Was permission obtained from the Conservation Division or its agents before plugging was commenced? Yes

Name of Conservation Agent who supervised plugging of this well G. Russell Biberstein
Producing formation None Depth to top Bottom Total Depth of Well 4830 Feet
Show depth and thickness of all water, oil and gas formations.

OIL, GAS OR WATER RECORDS

CASING RECORD

FORMATION	CONTENT	FROM	TO	SIZE	PUT IN	PULLED OUT
				20"	74'	None
				8-5/8"	1110'	None

Describe in detail the manner in which the well was plugged, indicating where the mud fluid was placed and the method or methods used in introducing it into the hole. If cement or other plugs were used, state the character of same and depth placed, from feet to feet for each plug set.

100 sack cement plug at 1200'.
15 sack cement plug at 40'.

RECEIVED
STATE CORPORATION COMMISSION
OCT 13 1970
CONSERVATION DIVISION
Wichita, Kansas

(If additional description is necessary, use BACK of this sheet)

Name of Plugging Contractor Bowers Drilling Company, Inc.
Address Wichita Plaza Building, Wichita, Kansas 67202

STATE OF Oklahoma, COUNTY OF Oklahoma, ss.
Neil G. Owens (employee of owner) or (owner) of the above-described

well, being first duly sworn on oath, says: That I have knowledge of the facts, statements, and matters herein contained and the log of the above-described well as filed and that the same are true and correct. So help me God.

(Signature) Neil G. Owens

1418 Liberty Bank Building, Oklahoma City, Ok.
(Address)

SUBSCRIBED AND SWORN TO before me this 12th day of October, 19 70

My commission expires October 28, 1972

Pat Pruitt
Notary Public.

WELL LOG

RECEIVED
OCT 12 1970
OKLA. CITY

COMPANY:
CONTRACTOR:
FARM:
LOCATION:

Midwest Oil Corp.
Bowers Drilling Company, Inc.
Baker #2
C NE NW
Sec. 25-33S-20W
Comanche Co., Kansas
9-24-70
10-4-70

COMMENCED:
COMPLETED:
ELEVATION:

0 - 360	Clay & red bed	
360 - 1745	Redbed	Set 35jts. 8 5/8" casing at 1110'
1745 - 2190	Shale	w/400 sks.
2190 - 4505	Lime and Shale	
4505 - 4830	Lime	
4830		T. D.

LOG TOPS:

RECEIVED
STATE CORPORATION COMMISSION
OCT 13 1970
CONSERVATION DIVISION
Wichita, Kansas

STATE OF KANSAS)
) SS
COUNTY OF SEDGWICK)

I, Emil E. Bowers, do hereby certify that the above and foregoing is a true and correct copy of the log of the #2 Baker located C NE NW, Sec. 25-33S-20W, Comanche County, Kansas, as reflected by the files of Bowers Drilling Company, Inc.

Emil E. Bowers
Emil E. Bowers, President

Subscribed and sworn to before me, a Notary Public, in and for the State of Kansas, this 9th day of October, 1970.

Carole A. Young
Carole A. Young, Notary Public

My commission expires May 12, 1973.

