

STATE OF KANSAS
STATE CORPORATION COMMISSION

Form CP-4


Give All Information Completely
Make Required Affidavit
Mail or Deliver Report to:
Conservation Division
State Corporation Commission
212 No. Market
Wichita, Kansas

WELL PLUGGING RECORD

Comanche County, Sec. 17 Twp. 33S Rge. 16W (35) (W)

Location as "NE/CNW/SW" or footage from lines C NW NW
Lease Owner Texas Oil & Gas Corporation
Lease Name Gregg-Gregg & Booth Well No. 1
Office Address 200 W. Douglas, Wichita, Kansas 67202
Character of Well (completed as Oil, Gas or Dry Hole) Dry Hole
Date well completed May 8, 19 74
Application for plugging filed May 8, 19 74
Application for plugging approved May 8, 19 74
Plugging commenced May 8, 19 74
Plugging completed May 8, 19 74
Reason for abandonment of well or producing formation Dry Hole.

NORTH

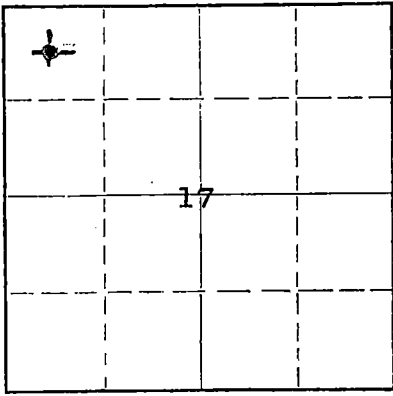

Locate well correctly on above Section Plat

If a producing well is abandoned, date of last production 19
Was permission obtained from the Conservation Division or its agents before plugging was commenced? Yes

Name of Conservation Agent who supervised plugging of this well
Producing formation Depth to top Bottom Total Depth of Well 5100 Feet
Show depth and thickness of all water, oil and gas formations.

OIL, GAS OR WATER RECORDS

CASING RECORD

FORMATION	CONTENT	FROM	TO	SIZE	PUT IN	PULLED OUT
		0	640'	8-5/8"	640'	None

Describe in detail the manner in which the well was plugged, indicating where the mud fluid was placed and the method or methods used in introducing it into the hole. If cement or other plugs were used, state the character of same and depth placed, from feet to feet for each plug set.

Hole filled with Mud 5100-640'
Plug 640-636'
Mud & Hulls 636-40'
Plug 40-36'
10 sacks cement 36-6'
2 sacks cement in Rat Hole.

RECEIVED
STATE CORPORATION COMMISSION
JUN 17 1974
6-17-74
CONSERVATION DIVISION
Wichita, Kansas

(If additional description is necessary, use BACK of this sheet)
Name of Plugging Contractor Allied Cementing Co.
Address Box 207, Russell, Kansas

STATE OF KANSAS, COUNTY OF SEDGWICK, ss.
John H. Knightley, (Agent) (employee of owner) or (owner or operator) of the above-described well, being first duly sworn on oath, says: That I have knowledge of the facts, statements, and matters herein contained and the log of the above-described well as filed and that the same are true and correct. So help me God.

(Signature) John H. Knightley
301 S. Broadway, Wichita, Kansas
(Address)

SUBSCRIBED AND SWORN TO before me this 14th day of June, 19 74

My commission expires March 12, 1975
Stella J. Lips Notary Public.

Texas Oil & Gas Corp. - Gregg-Gregg & Booth #1
C NW NW Sec. 17-33S-16W
Comanche County, Kansas

Contractor: D. R. Lauck Oil Company, Inc.
301 S. Broadway
Wichita, Kansas 67202

Commenced: April 22, 1974
Completed: May 8, 1974

RECEIVED
STATE CORPORATION COMMISSION

JUN 17 1974

CONSERVATION DIVISION
Wichita, Kansas

Drillers Log

Surface Soil--Clay, Shale	130
Shale	385
Sand & Shale	421
Shale	485
Shale & Shells	740
Sand & Shale	1014
Shale	1140
Shale & Shells	1865
Shale & Lime	2090
Lime & Shale	4260
Lime	5030
Lime & Chert	5100 RTD