

Give All Information Completely  
Make Required Affidavit  
Mail or Deliver Report to:  
Conservation Division  
State Corporation Commission  
211 No. Broadway  
Wichita, Kansas

WELL PLUGGING RECORD

Comanche County, Sec. 18 Twp. 33S Rge. 16W (E) (W)

Location as "NE/CNW%SW%" or footage from lines 660' f/N & 660' f/E lines

Lease Owner Continental Oil Company

Lease Name Shimer "B" Gas Unit Well No. 1

Office Address Box 30, Lyons, Kansas

Character of Well (completed as Oil, Gas or Dry Hole) Dry Hole

Date well completed 1-8- 19 63

Application for plugging filed 1-8- 19 63

Application for plugging approved 1-8- 19 63


Plugging commenced 1-8- 19 63

Plugging completed 1-9- 19 63

Reason for abandonment of well or producing formation Dry Hole

If a producing well is abandoned, date of last production 19

Was permission obtained from the Conservation Division or its agents before plugging was commenced? Yes

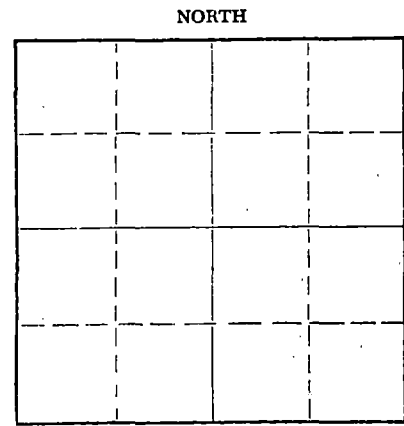

Locate well correctly on above Section Plat

Name of Conservation Agent who supervised plugging of this well Herman E. Justus Box 71, Nickerson, Kansas

Producing formation Depth to top Bottom Total Depth of Well 5060' Feet

Show depth and thickness of all water, oil and gas formations.

OIL, GAS OR WATER RECORDS

CASING RECORD

FORMATION	CONTENT	FROM	TO	SIZE	PUT IN	PULLED OUT
	Surface Csg.	-0-	398'	10 3/4"	398'	none
	Intermediate	-0-	994'	8 5/8"	994'	302'

Describe in detail the manner in which the well was plugged, indicating where the mud fluid was placed and the method or methods used in introducing it into the hole. If cement or other plugs were used, state the character of same and depth placed, from feet to feet for each plug set.

Filled hole with heavy mud from 5060' to 270', Set 1/2 sack hulls and 25 sacks cement at 270', Filled hole with heavy mud to 40', Set 1/2 sack hulls, Wooden plug, and 25-sack cement to surface. Completed 1-9-63

STATE CORPORATION COMMISSION  
JAN 14 1963  
1-14-63  
CONSERVATION DIVISION  
WICHITA, KANSAS

(If additional description is necessary, use BACK of this sheet)

Name of Plugging Contractor Strata Drilling, Inc.  
Address Box 355, Great Bend, Kansas

STATE OF Kansas, COUNTY OF Rice, ss. I, W. S. Akers (employee of owner) of the above-described well, being first duly sworn on oath, says: That I have knowledge of the facts, statements, and matters herein contained and the log of the above-described well as filed and that the same are true and correct. So help me God.

(Signature) [Signature] Box 30, Lyons, Kansas (Address)

SUBSCRIBED AND SWORN TO before me this 11th day of January, 19 63

My commission expires May 5, 1965  
State Corporation Commission  
CRW WSA

[Signature] Notary Public.

14

D R I L L E R S   L O G

#1 Shimer "B" Gas Unit

CASING RECORD: 398.73' of 10-3/4" Surface Casing.      COMPANY: Continental Oil Company      DESCRIPTION: NE NE Section 18-T33S-R16W Comanche Co., Kansas

CONTRACTOR: Strata Drilling, Inc.

TOTAL DEPTH: 5060'      COMMENCED: December 19, 1962

COMPLETED: January 9, 1963

D. & A.

<u>FORMATION</u>	<u>FROM</u>	<u>TO</u>	<u>REMARKS</u>
Shale	0	215	Ran 398.73' of 10-3/4" surface casing; set and cemented at 398.73' with 350 sacks of regular cement, 2% C. C.. Plug down at 9:05 A. M. December 21, 1962. Cement circ.
Red Bed	215	435	
Shale	435	560	Reamed 9-7/8" to 995'. Set 984' of new 8-5/8" surface casing; cemented with 100 sacks of regular cement, 2% Gel and 2% C. C.. Plug down at 5:15 A. M. December 23, 1962.
Red Bed, Shale & Shells	560	1275	
Shale	1275	2070	Rig shut down 48 hrs. for Xmas.
Lime & Shale	2070	4465	
Lime	4465	4790	Ran Electric Log.
Lime & Shale	4790	5005	
Chert	5005	5010	D. & A.
Chert & Lime	5010	5017	
Lime	5017	5030	Plugged as follows; plugged at 270' with 25 sacks of cement to 40'; plugged with 1/4 sack of hulls and 15 sacks of cement. Job completed at 4:30 A. M. January 9, 1963.
Lime & Chert	5030	5060	
Total Depth 5060'			

**RECEIVED**  
STATE CORPORATION COMMISSION

JAN 18 1963

CONSERVATION DIVISION  
Wichita, Kansas

STATE OF KANSAS )  
                          ) ss.  
COUNTY OF BARTON)

I certify that this is a true and correct copy of the above log to the best of my knowledge.

STRATA DRILLING, INC.

Charles W. Steincamp  
Charles W. Steincamp, President

Subscribed and sworn to before me this 10th day of January, 1963.

Elaine H. Taylor  
Elaine H. Taylor, Notary Public

My Commission Expires: December 14, 1965

STATE Corp. Comm.  
Kans Geol. and Society  
@ R W  
File