

15-033-00099-00-00


WELL PLUGGING RECORD

The All Information Completely
Make Required Affidavit
Mail or Deliver Report to:
Conservation Division
State Corporation Commission
211 No. Broadway
Wichita, Kansas

Comanche County. Sec. 36 Twp. 32S Rge. 18W (E) (W)

Location as "NE/CNW/SW" or footage from lines C SE NW
Lease Owner Hall-Jones Oil Corporation
Lease Name Parcel Well No. 1
Office Address 1710 Liberty Bank Bldg, Oklahoma City, Oklahoma
Character of Well (completed as Oil, Gas or Dry Hole) Dry Hole
Date well completed 3-12-64 19
Application for plugging filed 3-12-64 19
Application for plugging approved 3-12-64 19
Plugging commenced 3-12-64 19
Plugging completed 3-12-64 19
Reason for abandonment of well or producing formation Dry Hole

NORTH

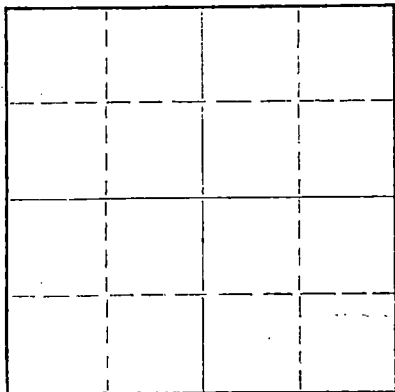

Locate well correctly on above Section Plat

If a producing well is abandoned, date of last production 19
Was permission obtained from the Conservation Division or its agents before plugging was commenced? yes

Name of Conservation Agent who supervised plugging of this well A. V. Elving, Pratt, Kansas
Producing formation Depth to top Bottom Total Depth of Well 5663 Feet
Show depth and thickness of all water, oil and gas formations.

OIL, GAS OR WATER RECORDS

CASING RECORD

FORMATION	CONTENT	FROM	TO	SIZE	PUT IN	PULLED OUT
	(this was previously set by Kiker Drilling Company)			8 5/8"	250'	

Describe in detail the manner in which the well was plugged, indicating where the mud fluid was placed and the method or methods used in introducing it into the hole. If cement or other plugs were used, state the character of same and depth placed, from feet to feet for each plug set.

Mud to 275' Plug 1/2 sk. hulls 25 sacks cement
Mud to 40' Plug & 1/2 sk. hulls and 10 sks. cement
5 sacks in rathole

RECEIVED
STATE CORPORATION COMMISSION
MAR 17 1964
03-17-1964
CONSERVATION DIVISION
Wichita, Kansas

(If additional description is necessary, use BACK of this sheet)
Name of Plugging Contractor Leben Drilling, Inc.
Address Box 486, Great Bend, Kansas

STATE OF KANSAS, COUNTY OF BARTON, ss.
Leslie Kite (employee of owner) or (owner or operator) of the above-described

well, being first duly sworn on oath, says: That I have knowledge of the facts, statements, and matters herein contained and the log of the above-described well as filed and that the same are true and correct. So help me God.

(Signature) Leslie Kite
Box 486, Great Bend, Kansas (Address)

SUBSCRIBED AND SWORN to before me this 16th day of March, 19 64

My commission expires April 1, 1967 Ulanda Nichols Notary Public.



15-133-00099-00-00

DRILLER'S LOG

COMPANY:	Hall-Jones Oil Corporation
CONTRACTOR:	LEBEN DRILLING, INC.
FARM:	PARCEL #1
LOCATION:	C SE NW Sec. 36-32S-18W COMANCHE COUNTY, KANSAS
COMMENCED:	2-22-64
COMPLETED:	3-12-64

0	1570	Open hole
1570	1795	Shale, Anhydrite, Gypsum
1795	2200	Redbed, Shale
2200	2320	Shale, Lime, Redbed
2320	2565	Shale, Lime
2565	2665	Shale
2665	2870	Lime, Shale
2870	3000	Shale
3000	3275	Shale & Lime
3275	3420	Shale
3420	3685	Shale & Lime
3685	3785	Lime & Shale
3785	4448	Shale & Lime
4448	5663	Lime
	<u>5663</u>	<u>Rotary Total Depth - d. & a.</u>

250' of 8 5/8" surface casing set previously by Kiker Drilling Co.

I, Leslie Kite, do hereby certify that the above and foregoing is a true and correct copy of the log of the Parcel #1, located C SE NW of Section 36, Township 32 South, Range 18 West, Comanche County, Kansas, as reflected by the files of Leben Drilling, Inc.

Leslie Kite

Leslie Kite

STATE OF KANSAS)
) SS
COUNTY OF BARTON)

Subscribed and sworn to before me, a Notary Public, in and for Barton County, Kansas, this 16th day of March, 1964.

Ulanda Nichols

Ulanda Nichols, Notary Public

My Commission Expires: April 1, 1967

RECEIVED
STATE CORPORATION COMMISSION

MAR 17 1964
03-17-1964
CONSERVATION DIVISION
Wichita, Kansas