


WELL PLUGGING RECORD

Give All Information Completely
Make Required Affidavit
Mail or Deliver Report to:
Conservation Division
State Corporation Commission
212 No. Market
Wichita, Kansas

NORTH

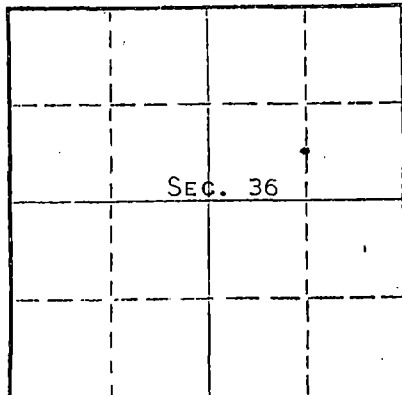

Locate well correctly on above
Section Plat

Location as "NE/CNW/SW" or footage from lines COMANCHE County, Sec. 36 Twp. 32s Rge. 17 (E) (W)
C S/2 NE
Lease Owner PETROLEUM, INC.
Lease Name WAGNER 'C' Well No. 1
Office Address R.R. #2, GREAT BEND, KANSAS
Character of Well (completed as Oil, Gas or Dry Hole) DRY HOLE
Date well completed FEBRUARY 6 19 67
Application for plugging filed FEBRUARY 6 19 67
Application for plugging approved FEBRUARY 6 19 67
Plugging commenced FEBRUARY 6 19 67
Plugging completed FEBRUARY 6 19 67
Reason for abandonment of well or producing formation NO PRODUCIBLE ZONE

If a producing well is abandoned, date of last production NONE 19
Was permission obtained from the Conservation Division or its agents before plugging was commenced? YES

Name of Conservation Agent who supervised plugging of this well ARCHIE ELVING
Producing formation Depth to top Bottom Total Depth of Well 5167 Feet
Show depth and thickness of all water, oil and gas formations.

OIL, GAS OR WATER RECORDS

CASING RECORD

FORMATION	CONTENT	FROM	TO	SIZE	PUT IN	PULLED OUT
				8-5/8"	414'	NONE

Describe in detail the manner in which the well was plugged, indicating where the mud fluid was placed and the method or methods used in introducing it into the hole. If cement or other plugs were used, state the character of same and depth placed, from feet to feet for each plug set.

MUD TO 400', 1/2 SACK HULLS, FOLLOWED BY WOODEN PLUG, PLACED 25 SACKS CEMENT ON TOP OF PLUG. MUD TO 40', 1/2 SACK HULLS, FOLLOWED BY WOODEN PLUG, PLACED 10 SACKS CEMENT ON TOP OF PLUG TO BASE OF WELL CELLAR.

RECEIVED
STATE CORPORATION COMMISSION
2-17-67
FEB 17 1967

CONSERVATION DIVISION
WICHITA, KANSAS

(If additional description is necessary, use BACK of this sheet)

Name of Plugging Contractor GARVEY DRILLING COMPANY
Address R.R. #2, GREAT BEND, KANSAS

STATE OF KANSAS, COUNTY OF BARTON, ss.
MONTE CHADD (employee of owner) or (owner or operator) of the above-described well, being first duly sworn on oath, says: That I have knowledge of the facts, statements, and matters herein contained and the log of the above-described well as filed and that the same are true and correct. So help me God. MONTE CHADD, DIST. PROD. SUPT.

(Signature) [Signature]
R.R. #2, GREAT BEND, KANSAS
(Address)

SUBSCRIBED AND SWORN to before me this 16 day of FEBRUARY, 19 67

My commission expires MAY 28, 1969

[Signature]
Notary Public.

WELL LOG

COMPANY Petroleum, Inc.

SEC. 36 T. 32S R. 17W

FARM Wagner "C"

NO. 1

LOC. C S/2 NE


TOTAL DEPTH 5167'

COUNTY Comanche

COMM. 1-23-67

COMP. 2-6-67

CONTRACTOR Garvey Drilling Company

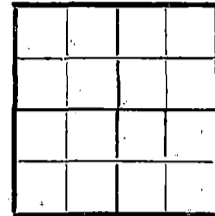

CASING 8 5/8" @ 414' w/250 sx

ELEVATION 1994' KB

PRODUCTION D & A

FIGURES INDICATE BOTTOM OF FORMATIONS

- 20' Sand
- 50' Shale and Sand
- 260' Red Bed
- 300' Anhydrite
- 575' Red Bed
- 800' Shale, Shells and Sand
- 1206' Shale and Shells
- 1633' Shale
- 1650' Anhydrite
- 1980' Shale and Lime
- 3485' Lime and Shale
- 3580' Shale and Lime
- 3818' Lime and Shale
- 4221' Shale and Lime
- 4460' Lime and Shale
- 4808' Lime
- 4860' Lime with Chert
- 4890' Lime
- 4970' Lime and Shale
- 5167' Lime
- 5167' RTD

RECEIVED
 OIL & GAS CORPORATION COMMISSION
 FEB 17 1967
 2-17-67
 CONSERVATION DIVISION
 Wichita, Kansas

State of Kansas
 County of Barton } ss

I, Sam N. Stephens of Garvey Drilling Company
 upon oath state the above and foregoing is a true and correct copy of the log of the Wagner "C" No. 1 well.

Sam N. Stephens

Subscribed and sworn to before me this 15th day of February 19 67

My Commission Expires: November 5th, 1969

Richard A. Boyz
 NOTARY PUBLIC