


15-033-00004-0000

STATE OF KANSAS
STATE CORPORATION COMMISSION

Give All Information Completely
Make Required Affidavit
Mail or Deliver Report to:
Conservation Division
State Corporation Commission
800 Bitting Building
Wichita, Kansas

WELL PLUGGING RECORD

NORTH

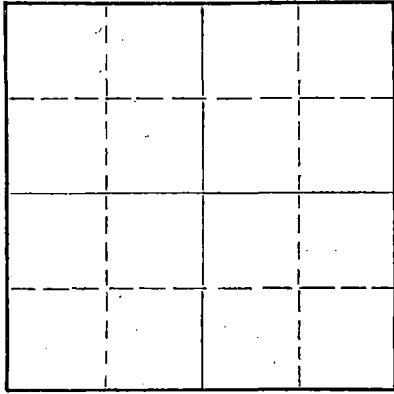

Locate well correctly on above
Section Plat

Comanche County. Sec. 12 Twp. 32 Rge. (E) 17 (W)
Location as "NE/CNW&SW" or footage from lines C SE NW
Lease Owner Rupp-Ferguson Oil Co.
Lease Name Isenbart Well No. 1
Office Address 523 Petroleum Bldg., Wichita, Kansas
Character of Well (completed as Oil, Gas or Dry Hole) Dry Hole
Date well completed 1-4-55 19
Application for plugging filed 1-4-55 19
Application for plugging approved 1-4-55 19
Plugging commenced 1-4-55 19
Plugging completed 1-4-55 19
Reason for abandonment of well or producing formation

If a producing well is abandoned, date of last production 19
Was permission obtained from the Conservation Division or its agents before plugging was commenced? Yes

Name of Conservation Agent who supervised plugging of this well M. A. Rives
Producing formation Depth to top Bottom Total Depth of Well 5177 Feet
Show depth and thickness of all water, oil and gas formations.

OIL, GAS OR WATER RECORDS

CASING RECORD

FORMATION	CONTENT	FROM	TO	SIZE	PUT IN	PULLED OUT
				13"	333'	0

Describe in detail the manner in which the well was plugged, indicating where the mud fluid was placed and the method or methods used in introducing it into the hole. If cement or other plugs were used, state the character of same and depth placed, from feet to feet for each plug set.

Filled hole w/mud to 330', pushed 1/2 sack hulls & plug to 330'. Cemented w/35 sacks. Filled hole w/mud to 30', pushed 1/2 sack hulls & plug to 30'. Cemented w/15 sacks to base of cellar.

(If additional description is necessary, use BACK of this sheet)

Name of Plugging Contractor Rupp-Ferguson Oil Co.
Address 523 Petroleum Bldg., Wichita, Kansas


STATE OF Kansas, COUNTY OF Sedgwick, ss.
L. W. Knox (employee of owner) or (owner or operator) of the above-described well, being first duly sworn on oath, says: That I have knowledge of the facts, statements, and matters herein contained and the log of the above-described well as filed and that the same are true and correct. So help me God.

(Signature) [Signature]
523 Petroleum Bldg., Wichita, Kansas (Address)

SUBSCRIBED AND SWORN TO before me this 13th day of January, 1955.

My commission expires June 4, 1955.

[Signature]
Notary Public.
RECEIVED
STATE CORPORATION COMMISSION
JAN 14 1955
WICHITA, KANSAS

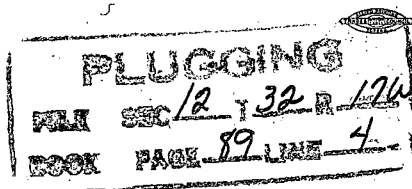

CONTRACTOR'S WELL LOG

Rupp-Ferguson No. 1 Isenbart
 C SE NW, Sec. 12-32-17W,
 Comanche County, Kansas

Results: D & A

333' of 13" casing w/300 sacks

Elevation 2099 KB

Commenced 12-18-54
 Completed 1-4-55

Figures Indicate Bottom of Formations:

170 sand & gravel
 190 sandy shale
 260 red bed
 295 sand
 326 red bed
 340 Anhydrite
 600 shale & shells
 960 sandy red bed
 1100 red bed, shale & shells
 1400 salt & shale
 2140 shale & shells
 2185 lime
 2610 lime & shale
 2683 lime
 2816 sandy lime, shale streaks
 2930 sandy lime & shale
 4578 shale & lime
 4861 lime
 5123 shale & lime
 5177 Miss.
 T.D.

Tops:

Elgin (Zone)	4156 (-2057)
Heebner	4292 (-2193)
Douglas	4354 (-2255)
Lansing-Kansas City	4463 (-2364)
Base Kansas City	4871 (-2772)
Mississippian	5116 (-3017)
Mississippi Chert	5123 (-3024)
Total Depth	5177 (-3078)

STATE OF KANSAS)
) SS:
 COUNTY OF SEDGWICK)

RECORDED
 STATE CORPORATION COMMISSION
 JAN 13 1955
 1-14-55
 CONSERVATION DIVISION
 Wichita, Kansas

I, L. W. Knox, Landman for Rupp-Ferguson Oil Co., do hereby certify that the above and foregoing is a true and correct copy of the log of the No. 1 Isenbart well.

L. W. Knox
 L. W. Knox

Subscribed and sworn to before me this 13th day of January, 1955.

Helen Horine
 Notary Public

My Commission Expires June 4, 1955.

PLUGGING
 FILE SEC 12 T 32 R 17W
 BOOK PAGE 89 LINE 4