

STATE OF KANSAS  
STATE CORPORATION COMMISSION

WELL PLUGGING RECORD


Give All Information Completely  
Make Required Affidavit  
Mail or Deliver Report to  
Conservation Division  
State Corporation Comm.  
245 North Water  
Wichita, KS 67202

Comanche County. Sec. 31 Twp. 32S Rge. 20W E/W  
Location as "NE/CNW $\frac{1}{4}$ SW $\frac{1}{4}$ " or footage from lines C SE SE  
660' FSL & 660' FEL

Lease Owner Texas Oil & Gas Corp.  
Lease Name EWY Well No. 1  
Office Address 200 W. Douglas, Suite 300, Wichita, KS 67202  
Character of Well (Completed as Oil, Gas or Dry Hole)

Dry hole

Date Well completed 6-7-77 19  
Application for plugging filed 6-7-77 19  
Application for plugging approved 6-7-77 19  
Plugging commenced 6-7-77 19  
Plugging completed 6-7-77 19  
Reason for abandonment of well or producing formation

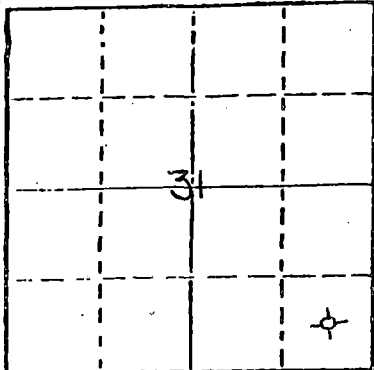

Locate well correctly on above  
Section Plat

If a producing well is abandoned, date of last production 19

Was permission obtained from the Conservation Division or  
its agents before plugging was commenced? Yes

Name of Conservation Agent who supervised plugging of this well J. H. Metz  
Producing formation Depth to top Bottom Total Depth of Well  
Show depth and thickness of all water, oil and gas formations.

OIL, GAS OR WATER RECORDS

CASING RECORD

FORMATION	CONTENT	FROM	TO	SIZE	PUT IN	PULLED OUT
		0	630'	8 5/8"	15jts.	

Describe in detail the manner in which the well was plugged, indicating where the mud fluid  
was placed and the method or methods used in introducing it into the hold. If cement or other  
plugs were used, state the character of same and depth placed, from feet to  
feet for each plug set.

@700' mud to 240' plug 25 sks cement @240 mud to 40'  
plug 1/2 sk hulls 12 sks to surface welded metal cap on top  
5 sks rat hole.

RECEIVED  
STATE CORPORATION COMMISSION  
JUN 14 1977  
6-14-77  
CONSERVATION DIVISION  
Wichita, Kansas

(If additional description is necessary, use BACK of this sheet)  
Name of Plugging Contractor Xplor Drilling co.

STATE OF KANSAS COUNTY OF SEDGWICK, ss.  
Wayne L. Kirkman (employee of owner) or (owner or operator)  
of the above-described well, being first duly sworn on oath, says: That I have knowledge of  
the facts, statements, and matters herein contained and the log of the above-described well  
as filed and that the same are true and correct. So help me God.

(Signature) Wayne L. Kirkman  
180 S. Rock Road, Suite 300, Wichita KS 67207  
(Address)

SUBSCRIBED AND SWORN TO before me this 9 day of June 19 77

Virginia Lee Smith  
Virginia Lee Smith, Notary Public.

