


Give All Information Completely  
Make Required Affidavit  
Mail or Deliver Report to:  
Conservation Division  
State Corporation Commission  
211 No. Broadway  
Wichita, Kansas

WELL PLUGGING RECORD

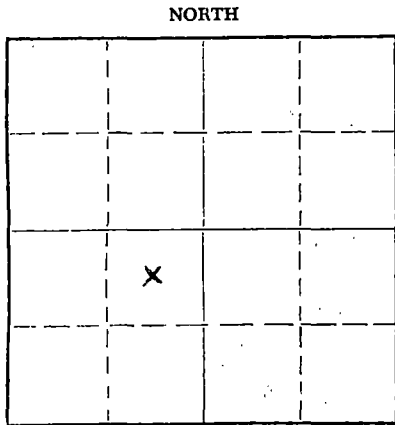

Locate well correctly on above Section Plat

Comanche County, Sec. 16 Twp. 32 Rge. (E) 18 (W)

Location as "NE/CNW/SW" or footage from lines C NE SW  
Lease Owner J. M. Huber Corporation  
Lease Name Herd Well No. 1  
Office Address 5415 North Pennsylvania, Oklahoma City, Oklahoma  
Character of Well (completed as Oil, Gas or Dry Hole) Gas  
Date well completed July 5 1962  
Application for plugging filed March 22 1967  
Application for plugging approved March 23 1967  
Plugging commenced April 6 1967  
Plugging completed April 8 1967  
Reason for abandonment of well or producing formation Miss. was uneconomical and Lan-KC produced water.  
If a producing well is abandoned, date of last production February 1967  
Was permission obtained from the Conservation Division or its agents before plugging was commenced? Yes

Name of Conservation Agent who supervised plugging of this well A. Elving, Pratt, Kansas  
Producing formation Miss and Lan-KC Depth to top 4726 Bottom 5230 Total Depth of Well 6016 Feet  
Show depth and thickness of all water, oil and gas formations.

OIL, GAS OR WATER RECORDS

CASING RECORD

FORMATION	CONTENT	FROM	TO	SIZE	PUT IN	PULLED OUT
Miss	Gas	5197	5230	4 1/2	5397	3205
Lan-KC	Wtr, Gas	4726	4736	4 1/2	5397	3205

Describe in detail the manner in which the well was plugged, indicating where the mud fluid was placed and the method or methods used in introducing it into the hole. If cement or other plugs were used, state the character of same and depth placed, from \_\_\_\_\_ feet to \_\_\_\_\_ feet for each plug set.

Pumped 30 sks cement into 4 1/2". Plug from 4400' to 4460'. Shot csg @ 4250, 3520, 3217;  
Pulled 101 jts 4 1/2" csg. Circ. 25 sks gel plug from 600' to 535'. Circ 50 sks cement into 13 3/8" surface csg from 535 to 455'. Circ 25 sks cement from surface to 30'.  
Cut 13 3/8" off 4' below G.L. and welded steel plate to surface casing.

RECEIVED  
STATE CORPORATION COMMISSION  
APR 20 1967  
04-20-1967  
CONSERVATION DIVISION  
WICHITA, KANSAS

(If additional description is necessary, use BACK of this sheet)

Name of Plugging Contractor Gayle E. Toland & Co.  
Address 1317 S. E. 29th Street, Oklahoma City, Oklahoma

STATE OF Oklahoma, COUNTY OF Oklahoma, ss.  
Bob Alexander (employee of owner) or (owner or operator) of the above-described well, being first duly sworn on oath, says: That I have knowledge of the facts, statements, and matters herein contained and the log of the above-described well as filed and that the same are true and correct. So help me God.

(Signature) Bob Alexander  
5415 N. PENN. OKLA. CITY, OKLA. (Address)

SUBSCRIBED AND SWORN TO before me this 19th day of April, 1967  
Deloris L. Parkerson

My commission expires January 9, 1967 Notary Public.