


15-033-20172-00-00

STATE OF KANSAS  
STATE CORPORATION COMMISSION  
CONSERVATION DIVISION  
P. O. BOX 17027  
WICHITA, KANSAS 67217

FORM CP-4

WELL PLUGGING RECORD

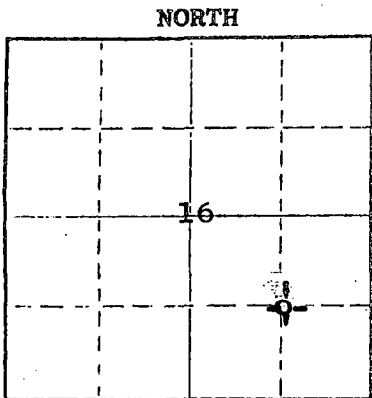

Locate well correctly on above Section Plot

Comanche County, Sec. 16 Twp. 32S Rgc. 18W (E) (W)  
Location as "NE/CNW&SW" or footage from lines. 15' N of C SE  
Lease Owner Texas Oil & Gas Corp.  
Lease Name Moyer "A" Well No. 1  
Office Address 200 W. Douglas, Suite 450, Wichita, Kansas  
Character of Well (completed as Oil, Gas or Dry Hole) Dry Hole  
Date well completed February 8, 19 75  
Application for plugging filed February 8, 19 75  
Application for plugging approved February 8, 19 75  
Plugging commenced February 8, 19 75  
Plugging completed February 8, 19 75  
Reason for abandonment of well or producing formation Dry Hole

If a producing well is abandoned, date of last production 19  
Was permission obtained from the Conservation Division or its agents before plugging was commenced? Yes

Name of Conservation Agent who supervised plugging of this well  
Producing formation Depth to top Bottom Total Depth of Well 5830 Feet  
Show depth and thickness of all water, oil and gas formations.

OIL, GAS OR WATER RECORDS				CASING RECORD		
FORMATION	CONTENT	FROM	TO	SIZE	PUT IN	FULLED OUT
		0'	625'	8-5/8"	625'	None

Describe in detail the manner in which the well was plugged, indicating where the mud fluid was placed and the method or methods used in introducing it into the hole. If cement or other plugs were used, state the character of same and depth placed, from feet to feet for each plug set.

5830'-250' - Hole filled with mud & hulls.  
250'-246' - Plug  
246'-40' - Cement, 35 sacks  
40'-36' - Plug  
36'-6' - Cement, 15 sacks (bottom of cellar)  
2 sacks cement in rat hole.

(If additional description is necessary, use BACK of this sheet)  
Name of Plugging Contractor Halliburton Cementing Co.  
Address Pratt, Kansas

STATE OF KANSAS COUNTY OF SEDGWICK

John D. Knightley, Agent of the above-described well, being first duly sworn on oath, says: That I have knowledge of the facts, statements, and matters herein contained and the log of the above-described well as filed and that the same are true and correct. So help me God.

(Signature) [Signature]  
301 S. Broadway, Wichita, Kansas  
(Address)

SUBSCRIBED AND SWORN TO before me this 14th day of February, 19 75

My commission expires March 12, 1975 [Signature] Notary Public.

RECEIVED  
STATE CORPORATION COMMISSION  
FEB 19 1975  
CONSERVATION DIVISION  
Wichita, Kansas

02-19-1975

15-033-20172-00-00

Texas Oil & Gas Corp. -

Moyer #1 (Moyer "A" #1 15' N of C SE)  
C SE Sec. 16-32S-18W  
Comanche County, Kansas

Contractor: D. R. Lauck Oil Company, Inc.  
301 S. Broadway  
Wichita, Kansas 67202

Commenced: January 12, 1975  
Completed: February 9, 1975

Drillers Log

Clay	50
Sand & Shale Streaks	215
Shale	254
Gyp	264
Shale	284
Gyp	403
Shale	1069
Anhydrite	1080
Shale	1570
Shale & Shells	1975
Shale	2230
Lime & Shale	3295
Shale & Lime	3665
Lime	3965
Lime & Shale	4065
Lime	4185
Lime & Shale	4310
Shale & Lime	4450
Shale	4524
Lime	5620
Shale & Lime	5710
Lime & Shale	5740
Shale	5830 RTD

RECEIVED  
STATE CORPORATION COMMISSION

FEB 19 1975

CONSERVATION DIVISION  
Wichita, Kansas

02-19-1975