

CARD MUST BE TYPED

State of Kansas

CARD MUST BE SIGNED

NOTICE OF INTENTION TO DRILL

(see rules on reverse side)

516

Expected Spud Date. 10 4 87
month day year

API Number 15— 033-20,714-~~0000~~

OPERATOR: License # 3536
Name Ramco Drilling Services, Inc.
Address P.O. Box 99
City/State/Zip Belpre, Ohio 45714
Contact Person. Bob Williamson/David Gocke
Phone 614-423-9591

NW NW NW Sec. 19 Twp. 32 S, Rg. 19 W East
 West
4950 Ft. from South Line of Section
4950 Ft. from East Line of Section

(Note: Locate well on Section Plat on reverse side)

CONTRACTOR: License # 5302
Name Red Tiger Drilling Co.
City/State Wichita, KS 67202

Nearest lease or unit boundary line 330 feet
County Comanche
Lease Name Lawrence Rich Well # 1

Well Drilled For: Well Class: Type Equipment:
 Oil Storage Infield Mud Rotary
 Gas Inj Pool Ext. Air Rotary
 OWWO Expl Wildcat Cable

Ground surface elevation 1951 feet MSL
Domestic well within 330 feet: yes no
Municipal well within one mile: yes no

If OWWO: old well info as follows:
Operator
Well Name
Comp Date Old Total Depth

Depth to bottom of fresh water 100
Depth to bottom of usable water 200
Surface pipe by Alternate: 1 2
Surface pipe planned to be set 650' 8 5/8"
Conductor pipe required 80' 13-3/8"
Projected Total Depth 5220 feet
Formation Miss

I certify that well will comply with K.S.A. 55-101, et seq. and will eventually plug and seal to KCC specifications.
Date 9-29-87 Signature of Operator or Agent George A. Oyle Owner

For KCC Use: BY RED TIGER DRILLING COMPANY
Conductor Pipe Required feet; Minimum Surface Pipe Required 200 feet per Alt.

This Authorization Expires 3-30-88 Approved By R.H. 9-30-87


EFFECTIVE DATE: 10-4-87

Must be filed with the K.C.C. five (5) days prior to commencing well
This card void if drilling not started within six (6) months of date received by K.C.C.

Important procedures to follow:

1. Notify District office before setting surface casing.
 2. Set surface casing by circulating cement to the top.
 3. File completion forms ACO-1 with K.C.C. within 120 days of well spud date, following instructions on ACO-1, side I, and including copies of wireline logs.
 4. Notify District office 48 hours prior to old well workover or re-entry.
 5. Prior to filing Intent, prepare a proposed plugging plan in case well is D & A, then obtain approval of plan when calling district office prior to setting surface pipe.
 6. Submit plugging report (CP-4) to K.C.C. after plugging is completed.
- Obtain an approved injection docket number before disposing of salt water.
- Notify K.C.C. within 10 days when injection commences or terminates.
- If an alternate 2 completion, cement in the production pipe from below any usable water to surface within 120 days of spud date.

A Regular Section of Land
1 Mile = 5,280 Ft.

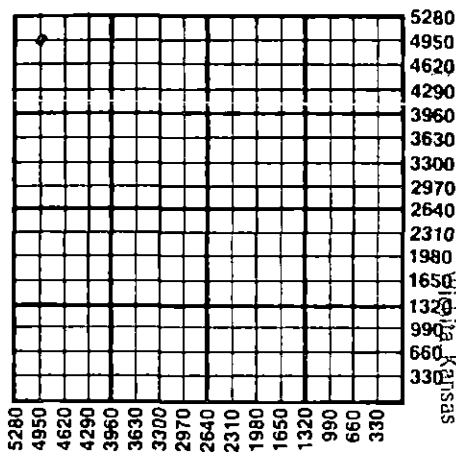

CONSERVATION DIVISION
STATE CORPORATION COMMISSION
WICHITA, KANSAS

SEP 30 1987
9-30-87

RECEIVED
STATE CORPORATION COMMISSION

State Corporation Commission of Kansas
Conservation Division
200 Colorado Derby Building
Wichita, Kansas 67202-1212
(316) 263-3238