

CARD MUST BE TYPED

State of Kansas

CARD MUST BE SIGNED

NOTICE OF INTENTION TO DRILL

(see rules on reverse side)

DA

Expected Spud Date. 10-13-88
month day year

API Number 15- 033-20,733-0000

OPERATOR: License # 5428
Name Graves Drilling Co., Inc.
Address 151 N. Main, Suite 850
City/State/Zip Wichita, KS 67202
Contact Person Karen L. Seiler
Phone 316-265-7233

C NW NE Sec 17 Twp 32 S, Rg. 17 East
4620 West
1980 Ft. from South Line of Section
Ft. from East Line of Section

(Note: Locate well on Section Plat on reverse side)

CONTRACTOR: License # 5123
Name Pickrell Drilling Company
City/State Wichita, KS 67202

Nearest lease or unit boundary line 660 feet
County Comanche
Lease Name Peoples Well # 1
Ground surface elevation 2080' (Topo) feet MSL

Well Drilled For: Well Class: Type Equipment:
X Oil Storage Infield Mud Rotary
X Gas Inj Pool Ext. Air Rotary
OWWO Expl Wildcat Cable

Domestic well within 330 feet: yes X no
Municipal well within one mile: yes X no

If OWWO: old well info as follows:

Operator
Well Name
Comp Date Old Total Depth

Depth to bottom of fresh water 230
Depth to bottom of usable water 600
Surface pipe by Alternate: 1 X 2
Surface pipe planned to be set 650'
Conductor pipe required
Projected Total Depth 5800' feet
Formation Simpson

I certify that well will comply with K.S.A. 55-101, et seq., plus eventually plugging hole to KCC specifications.

Date 10-10-88 Signature of Operator or Agent [Signature] Title Geologist

For KCC Use:

Conductor Pipe Required feet; Minimum Surface Pipe Required 250' feet per Alt. 1 X

This Authorization Expires 1-10-89 Approved By LKM 10-10-88


EFFECTIVE DATE: 10-15-88

Must be filed with the K.C.C. five (5) days prior to commencing well
This card void if drilling not started within six (6) months of date received by K.C.C.

Important procedures to follow:

1. Notify District office before setting surface casing.
2. Set surface casing by circulating cement to the top.
3. File completion forms ACO-1 with K.C.C. within 120 days of well spud date, following instructions on ACO-1, side 1, and including copies of wireline logs.
4. Notify District office 48 hours prior to old well workover or re-entry.
5. Prior to filing Intent, prepare a proposed plugging plan in case well is D & A, then obtain approval of plan when calling district office prior to setting surface pipe.
6. Submit plugging report (CP-4) to K.C.C. after plugging is completed.
7. Obtain an approved injection docket number before disposing of salt water.
8. Notify K.C.C. within 10 days when injection commences or terminates.

A Regular Section of Land 1 Mile = 5,280 Ft.

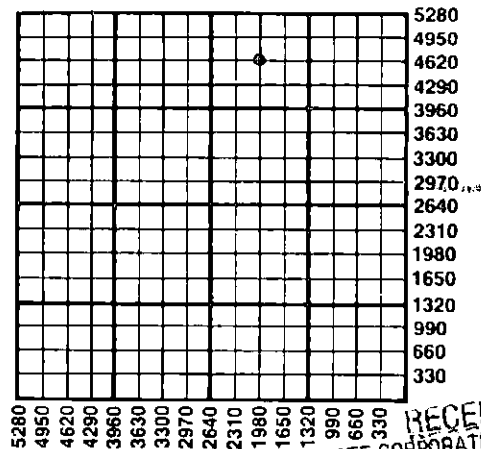

RECEIVED
STATE CORPORATION COMMISSION

OCT 10 1988
10-10-88
CONSERVATION DIVISION
Wichita, Kansas

If an alternate 2 completion, cement in the production pipe from below any usable water to surface within 120 days of spud date.

State Corporation Commission of Kansas
Conservation Division
200 Colorado Derby Building
Wichita, Kansas 67202-1212
(316) 263-3238