

CARD MUST BE TYPED

State of Kansas

CARD MUST BE SIGNED

NOTICE OF INTENTION TO DRILL

(see rules on reverse side)

✓ DA

Expected Spud Date... October 25, 1988
month day year

API Number 15— 033-20,734-0000

OPERATOR: License # 5428

C NE NW Sec. 12 Twp. 33 S, Rg. 19 X East West

Name Graves Drilling Co., Inc.

4620 Ft. from South Line of Section

Address 151 N. Main, Suite 850

3300 Ft. from East Line of Section

City/State/Zip Wichita, KS 67202

(Note: Locate well on Section Plat on reverse side)

Contact Person Karen L. Seiler

Nearest lease or unit boundary line 660 feet

Phone 316-265-7233

County Comanche

CONTRACTOR: License # 5123

Lease Name Kaniss Well # 1

Name Pickrell Drilling Company

Ground surface elevation 2068 GL feet MSL

City/State Wichita, KS 67202

Domestic well within 330 feet: yes X no

Well Drilled For: Well Class: Type Equipment:

Municipal well within one mile: yes X no

X Oil Storage Infield Mud Rotary

Depth to bottom of fresh water 230'

X Gas Inj Pool Ext. Air Rotary

Depth to bottom of usable water 500 400'

OWWO Expl Wildcat Cable

Surface pipe by Alternate: 1 X 2

If OWWO: old well info as follows:

Surface pipe planned to be set 675'

Operator

Conductor pipe required

Well Name

Projected Total Depth 6100 feet

Comp Date..... Old Total Depth.....

Formation Simpson

I certify that well will comply with K.S.A. 55-101, et seq., plus eventually plugging hole to KCC specifications.

Date 10-17-88 Signature of Operator or Agent Richard M. Linneman Title Geologist

For KCC Use:

Conductor Pipe Required feet; Minimum Surface Pipe Required 420' feet per Alt. (1) X

This Authorization Expires 4-18-89 Approved By LKM 10-18-88


EFFECTIVE DATE: 10-23-88

Must be filed with the K.C.C. five (5) days prior to commencing well
This card void if drilling not started within six (6) months of date received by K.C.C.

Important procedures to follow:

1. Notify District office before setting surface casing.
 2. Set surface casing by circulating cement to the top.
 3. File completion forms ACO-1 with K.C.C. within 120 days of well spud date, following instructions on ACO-1, side 1, and including copies of wireline logs.
 4. Notify District office 48 hours prior to old well workover or re-entry.
 5. Prior to filing Intent, prepare a proposed plugging plan in case well is D & A, then obtain approval of plan when calling district office prior to setting surface pipe.
 6. Submit plugging report (CP-4) to K.C.C. after plugging is completed.
- Notify K.C.C. within 10 days when injection commences or terminates.

A Regular Section of Land
1 Mile = 5,280 Ft.

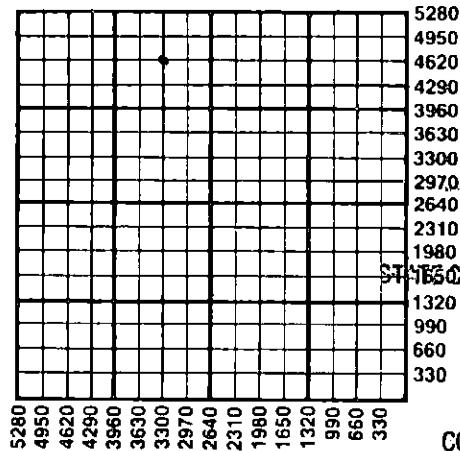

RECEIVED
OCT 18 1988
10-18-88
CONSERVATION DIVISION
Wichita, Kansas

State Corporation Commission of Kansas
Conservation Division
200 Colorado Derby Building
Wichita, Kansas 67202-1212
(316) 263-3238