


COPY

STATE OF KANSAS
STATE CORPORATION COMMISSION

WELL PLUGGING RECORD

Give All Information Completely
Make Required Affidavit
Mail or Deliver Report to
Conservation Division
State Corporation Comm.
245 North Water
Wichita, KS 67202

Comanche County, Sec. 8 Twp. 33S Rge. 18 ~~XX~~/W
Location as "NE/CNW 1/4 SW 1/4" or footage from lines

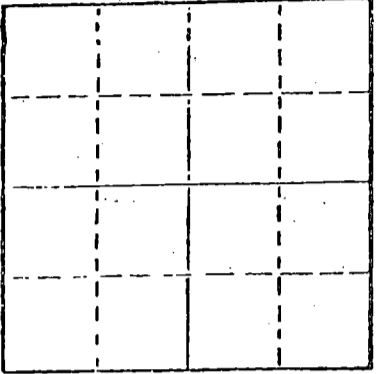

Locate well correctly on above
Section Plot

NW NW
Lease Owner K.R.M. Petroleum Corp.
Lease Name R. H. Phillips "D" Well No. 1
Office Address 817 17th. St. Denver Colo. 80202
Character of Well (Completed as Oil, Gas or Dry Hole)
DRY HOLE
Date Well completed 11-2-78 19
Application for plugging filed 11-2-78 19
Application for plugging approved 11-2-78 19
Plugging commenced 11-2-78 19
Plugging completed 11-2-78 19
Reason for abandonment of well or producing formation

If a producing well is abandoned, date of last production 19
Was permission obtained from the Conservation Division or
its agents before plugging was commenced? YES

Name of Conservation Agent who supervised plugging of this well Bill Owen
Producing formation Depth to top Bottom Total Depth of Well 6310'
Show depth and thickness of all water, oil and gas formations.

OIL, GAS OR WATER RECORDS

CASING RECORD

FORMATION	CONTENT	FROM	TO	SIZE	PUT IN	PULLED OUT
			0	630'	16 jts.	

Describe in detail the manner in which the well was plugged, indicating where the mud fluid was placed and the method or methods used in introducing it into the hold. If cement or other plugs were used, state the character of same and depth placed, from feet to feet for each plug set.

@630' 50 sacks cement, @40' 1/2 sack hulls, CEIVED
wooden plug, 12 sacks cement, 3 sacks cement
in rat hole. Completed @11:00 A.M. 11-2-78.

NOV - 7 1978
11-7-78
CONSERVATION DIVISION
Wichita, Kansas

(If additional description is necessary, use BACK of this sheet)

Name of Plugging Contractor Allied Cementing, Pratt KS.

STATE OF KANSAS COUNTY OF SEDGWICK, ss.
Kirby C. Evers (employee of owner) or


of the above-described well, being first duly sworn on oath, says: That I have knowledge of the facts, statements, and matters herein contained and the log of the above-described well as filed and that the same are true and correct. So help me God.

(Signature) Kirby C. Evers
453 S. Webb Rd., Wichita, KS. 67207
(Address)

SUBSCRIBED AND SWORN TO before me this 6 day of November, 1978

Virginia Lee Smith, Notary Public.

My commission expires August 25, 1980

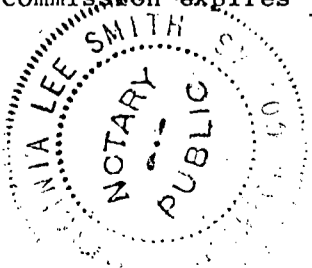

copy

WELL LOG

R.H. PHILLIPS "D"
 NW NW Section 8-33S-18W
 Comanche County, Kansas

OPERATOR: K.R.M. PETROLEUM CORP. COMMENCED: 10-20-78
 CONTRACTOR: XPLOR DRILLING CO. COMPLETED: 11-2-78

CASING RECORD: Ran 16jts. 8 5/8" casing, 24# new set @630, cement with
 530 sacks cement, 250 sacks Lite Weight, 3% cal. chloride,
 280 sacks Common, 3% cal.chloride, 2% gel.

<u>FORMATION</u>	<u>FROM</u>	<u>TO</u>	<u>ELEVATION</u>
Red Bed & Shale	0	338	
Lime & Shale	338	6310	
R.T.D	6310		

STATE OF KANSAS)
) SS:
 COUNTY OF SEDGWICK)

I certify that this is a true and correct copy of the Driller's Log of the well drilled NW NW of Section 8-33S-18W, Comanche County, Kansas to the best of my knowledge and belief.

XPLOR DRILLING CO.

Kirby C. Evers
 Kirby C. Evers, Vice President

Subscribed and sworn to before me this 6th. day of November, 1978.

MY COMMISSION EXPIRES:
 August 25, 1980

Virginia Lee Smith
 Virginia Lee Smith, Notary Public

RECEIVED
 STATE CORPORATION COMMISSION

NOV - 7 1978
 11-7-78
 CONSERVATION DIVISION
 Wichita, Kansas

