


STATE OF KANSAS
STATE CORPORATION COMMISSION

WELL PLUGGING RECORD

Give All Information Completely
Make Required Affidavit
Mail or Deliver Report to
Conservation Division
State Corporation Comm.
245 North Water
Wichita, KS 67202

COMANCHE County. Sec. 16 Twp. 32 Rge. 17 (W)
Location as "NE/CNW $\frac{1}{4}$ SW $\frac{1}{4}$ " or footage from lines _____
C SW SE
Lease Owner CITIES SERVICE COMPANY
Lease Name BELCHER "B" Well No. #1
Office Address 700 Sutton Place Bldg. 209 E. William, Wichita, KS
Character of Well (Completed as Oil, Gas or Dry Hole) _____

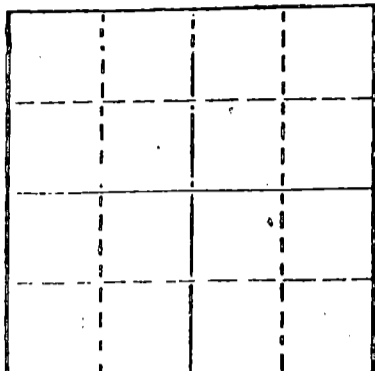

Locate well correctly on above
Section Plot

DRY HOLE
Date Well completed 9-8 1978
Application for plugging filed 9-8 1978
Application for plugging approved 9-11 1978
Plugging commenced 9-8 1978
Plugging completed 9-8 1978

Reason for abandonment of well or producing formation
DRY HOLE

If a producing well is abandoned, date of last production
19

Was permission obtained from the Conservation Division or
its agents before plugging was commenced? YES

Name of Conservation Agent who supervised plugging of this well Wm. T. Owen
Producing formation _____ Depth to top _____ Bottom _____ Total Depth of Well 5180
Show depth and thickness of all water, oil and gas formations.

OIL, GAS OR WATER RECORDS

CASING RECORD

FORMATION	CONTENT	FROM	TO	SIZE	PUT IN	PULLED OUT
				8 5/8"	594'	0'

Describe in detail the manner in which the well was plugged, indicating where the mud fluid was placed and the method or methods used in introducing it into the hold. If cement or other plugs were used, state the character of same and depth placed, from _____ feet to _____ feet for each plug set. 50 SX cement plug at 600'!

12 SX plug cement 40'. 3 SX plug in rat hole.

RECEIVED
STATE CORPORATION COMMISSION

OCT 16 1978
10-16-78

CONSERVATION DIVISION
Wichita, Kansas

(If additional description is necessary, use BACK of this sheet)

Name of Plugging Contractor GABBERT-JONES

STATE OF KANSAS COUNTY OF SEDGWICK, ss.
W. J. Devaney (employee of owner) or (owner or operator)

of the above-described well, being first duly sworn on oath, says: That I have knowledge of the facts, statements, and matters herein contained and the log of the above-described well as filed and that the same are true and correct. So help me God.

Glenn E. Meier
STATE NOTARY PUBLIC
Sedgwick County, Kansas

(Signature)

W. J. Devaney
700 Sutton Pl. Bldg. Wichita, KS 67202
(Address)

SUBSCRIBED AND SWORN TO before me this 16 day of October, 1978

Glenn E. Meier
Notary Public.

My commission expires 6-3-81

