


STATE OF KANSAS
STATE CORPORATION COMMISSION

WELL PLUGGING RECORD

Give All Information Completely
Make Required Affidavit
Mail or Deliver Report to
Conservation Division
State Corporation Comm.
245 North Water
Wichita, KS 67202

Comanche County, Sec. 20 Twp. 32S Rge. 17 ~~XXW~~
Location as "NE/CNW $\frac{1}{4}$ SW $\frac{1}{4}$ " or footage from lines
C NE NW

Lease Owner PAR Petroleum, Inc.
Lease Name Deewall Well No. 1
Office Address P. O. Box 280, Liberal, Kansas 67901
Character of Well (Completed as Oil, Gas or Dry Hole) dry hole

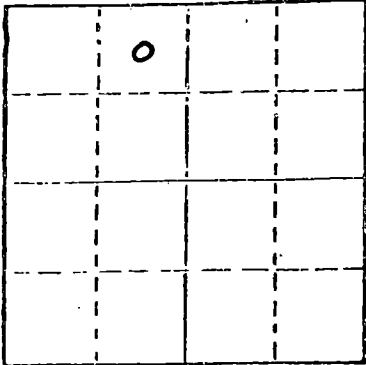

Locate well correctly on above
Section Plat

Date Well completed January 18 1982
Application for plugging filed verbal agreement 19
Application for plugging approved 19
Plugging commenced January 31 1982
Plugging completed January 31 1982
Reason for abandonment of well or producing formation dry hole

If a producing well is abandoned, date of last production 19

Was permission obtained from the Conservation Division or
its agents before plugging was commenced? yes

Name of Conservation Agent who supervised plugging of this well Paul Luthi
Producing formation _____ Depth to top _____ Bottom _____ Total Depth of Well 998'
Show depth and thickness of all water, oil and gas formations.

OIL, GAS OR WATER RECORDS

CASING RECORD

FORMATION	CONTENT	FROM	TO	SIZE	PUT IN	PULLED OUT
				16"	85'	none

Describe in detail the manner in which the well was plugged, indicating where the mud fluid was placed and the method or methods used in introducing it into the hold. If cement or other plugs were used, state the character of same and depth placed, from _____ feet to _____ feet for each plug set.

Washed hole down with 180' of 2" tubing and circulated 200 sx cement to surface, leaving 180' 2" tubing in the hole.

RECEIVED
STATE CORPORATION COMMISSION

FEB 18 1982
2-18-82
CONSERVATION DIVISION
Wichita, Kansas

(If additional description is necessary, use BACK of this sheet)

Name of Plugging Contractor Halliburton Services

STATE OF Kansas COUNTY OF Seward, ss.
Rodney R. Reynolds (employee of owner) or (owner or operator)
of the above-described well, being first duly sworn on oath, says: That I have knowledge of the facts, statements, and matters herein contained and the log of the above-described well as filed and that the same are true and correct. So help me God.

(Signature) Rodney R. Reynolds
P. O. Box 280, Liberal, Kansas 67901
(Address)

SUBSCRIBED AND SWORN TO before me this 16th day of February, 19 82
Marjorie A. Kennedy
Notary Public.
My commission expires Jan 8, 1984

