


STATE OF KANSAS
STATE CORPORATION COMMISSION

WELL PLUGGING RECORD

Give All Information Completely
Make Required Affidavit
Mail or Deliver Report to
Conservation Division
State Corporation Comm.
245 North Water
Wichita, KS 67202

Comanche County. Sec. 34 Twp. 32S Rge. 17W E/W
Location as "NE/CNW $\frac{1}{4}$ SW $\frac{1}{4}$ " or footage from lines
C NE/4 SE/4

Lease Owner Mid-Continent Energy Corporation
Lease Name Einsel Well No. #2
Office Address 120 S. Market, Suite 712, Wichita, KS 67202
Character of Well (Completed as Oil, Gas or Dry Hole) Dry Hole

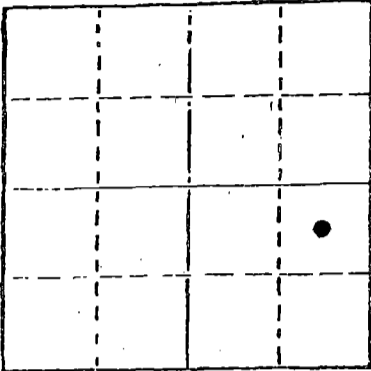

Locate well correctly on above
Section Plot

Date Well completed October 7, 1979
Application for plugging filed October 7, 1979
Application for plugging approved October 7, 1979
Plugging commenced October 7, 1979
Plugging completed October 7, 1979
Reason for abandonment of well or producing formation _____

If a producing well is abandoned, date of last production
19 _____

Was permission obtained from the Conservation Division or
its agents before plugging was commenced? Yes

Name of Conservation Agent who supervised plugging of this well Duane Ranker
Producing formation N/A Depth to top _____ Bottom _____ Total Depth of Well 5260'
Show depth and thickness of all water, oil and gas formations.

OIL, GAS OR WATER RECORDS

CASING RECORD

FORMATION	CONTENT	FROM	TO	SIZE	PUT IN	PULLED OUT
Nippewalla Group	SS, Sh, Gypsum	0'	523'	8-5/8"	523'	None

Describe in detail the manner in which the well was plugged, indicating where the mud fluid was placed and the method or methods used in introducing it into the hold. If cement or other plugs were used, state the character of same and depth placed, from _____ feet to _____ feet for each plug set.

510' - 50 sks of 50/50 Poz w/ 4% gel

40' - 10 sks of " "

Mouse Hole - 5 sks of " "

Rat Hole - 3 sks of " "

RECEIVED
STATE CORPORATION COMMISSION

OCT 5 1979
12-5-79
CONSERVATION DIVISION
Wichita, Kansas

(If additional description is necessary, use BACK of this sheet)

Name of Plugging Contractor Venture Drilling, Inc.


STATE OF Kansas COUNTY OF Sedgwick, ss.
Richard L. Bradford (employee or owner or operator)
of the above-described well, being first duly sworn on oath, says: That I have knowledge of the facts, statements, and matters herein contained and the log of the above-described well as filed and that the same are true and correct. So help me God.

(Signature) Richard L. Bradford
Mid-Continent Energy Corp., 120 S. Market, Suite #712, Wichita, (Address) KS 67202

SUBSCRIBED AND SWORN TO before me this 3rd day of December, 19 79

Anita H. Goetz
Anita H. Goetz Notary Public.

My commission expires

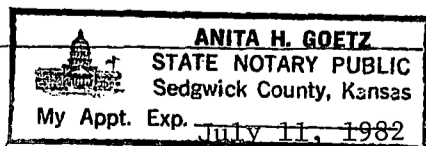

DRILLERS LOG

OPERATOR: Mid-Continent Energy Corporation
 120 S. Market, Suite 712
 Wichita, KS 67202

LEASE: Einsel #2
 C NE/4 SE/4 of Sec. 34-T32S-R17W
 Comanche County, KS

CONTRACTOR: Venture Drilling, Inc.
 Suite 1625, KSB&T Bldg.
 Wichita, KS 67202

COMMENCED: September 22, 1979

COMPLETED: October 7, 1979

RTD: 5260'

SURFACE CASING: 8-5/8" set at 523' with 375 sks cement

 5260' - R.T.D.

RECEIVED
 STATE CORPORATION COMMISSION
 DEC - 5 1979
 12-5-79
 CONSERVATION DIVISION
 Wichita, Kansas

STATE OF KANSAS

COUNTY OF SEDGWICK

I, Richard L. Bradford, of the Mid-Continent Energy Corporation, hereby state the above and foregoing is an accurate copy of the Einsel #2 Log.

Richard L. Bradford
 Richard L. Bradford, Vice-President

Subscribed and sworn to me this
 3rd day of December, 1979.

Anita H. Goetz
 Anita H. Goetz, Notary Public

ANITA H. GOETZ
 STATE NOTARY PUBLIC
 Sedgwick County, Kansas
 My Appt. Exp. July 11, 1982

My appointment expires: _____