


STATE OF KANSAS
STATE CORPORATION COMMISSION

Give All Information Completely
Make Required Affidavit
Mail or Deliver Report to:
Conservation Division
State Corporation Commission
212 North Market, Insurance Bldg.
Wichita, Kansas

WELL PLUGGING RECORD

K

NORTH

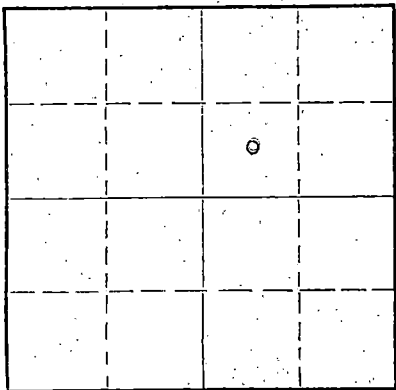

Locate well correctly on above
Section Plat

Comanche County. Sec. 35 Twp. 33S Rge. 18W (E) (W)
Location as "NE/CNW/SW" or footage from lines. C SW/1 NE/1
Lease Owner Youngblood & Youngblood
Lease Name Betzer Well No. 1
Office Address Box 552, Oklahoma City, Oklahoma
Character of Well (completed as Oil, Gas or Dry Hole) Dry Hole
Date well completed December 20 1960
Application for plugging filed December 20 1960
Application for plugging approved December 20 1960
Plugging commenced December 21 1960
Plugging completed 9:00 a. m. December 21 1960
Reason for abandonment of well or producing formation
Dry Hole

If a producing well is abandoned, date of last production 19
Was permission obtained from the Conservation Division or its agents before plugging was commenced? Yes

Name of Conservation Agent who supervised plugging of this well W. L. LaKamp, Jr.
Producing formation None Depth to top Bottom Total Depth of Well 6315 Feet
Show depth and thickness of all water, oil and gas formations.

OIL, GAS OR WATER RECORDS

CASING RECORD

FORMATION	CONTENT	FROM	TO	SIZE	PUT IN	PULLED OUT
	Surface Casing	0	351	13-3/8	351	None

Describe in detail the manner in which the well was plugged, indicating where the mud fluid was placed and the method or methods used in introducing it into the hole. If cement or other plugs were used, state the character of same and depth placed, from feet to feet for each plug set.

Hole was filled with heavy 60 viscosity drilling mud from 6315' to 350'.
Cement plug placed from 350' to 300'. Heavy drilling mud placed from 300' to 28'.
Cement plug placed from 28' to 3'. Steel cap screwed onto 13-3/8" casing. Hole filled with surface dirt from 3' to ground level.

RECEIVED
STATE CORPORATION COMMISSION

DEC 30 1960
12-30-60
CONSERVATION DIVISION
Wichita, Kansas

(If additional description is necessary, use BACK of this sheet)

Name of Plugging Contractor Holm Drilling Company
Address Box 7505, Tulsa, Oklahoma

STATE OF Oklahoma, COUNTY OF Oklahoma, ss.
H. M. Frost (employee of owner) or (owner or operator) of the above-described well, being first duly sworn on oath, says: That I have knowledge of the facts, statements, and matters herein contained and the log of the above-described well as filed and that the same are true and correct. So help me God.

(Signature) H. M. Frost
Box 552, Oklahoma City, Oklahoma (Address)

SUBSCRIBED AND SWORN TO before me this 22 day of December, 1962
Carl A. Robinson
Notary Public.

My commission expires October 12, 1962

