

15-033-20037-0000


STATE OF KANSAS
STATE CORPORATION COMMISSION

Form CP-4

Give All Information Completely
Make Required Affidavit
Mail or Deliver Report to:
Conservation Division
State Corporation Commission
P. O. Box 17027
Wichita, Kansas 67217
NORTH

WELL PLUGGING RECORD

Comanche County, Sec. 13 Twp. 33S Rge. 18W (E) (W)
NW SW

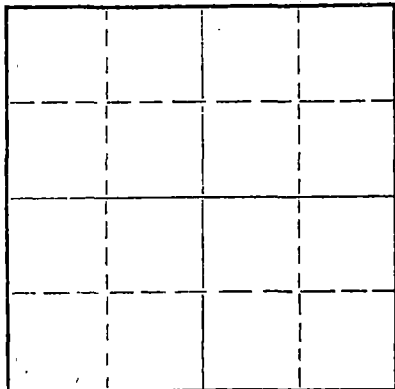

Locate well correctly on above
Section Plat

Location as "NE/CNW/SW" or footage from lines _____
Lease Owner B.D. and M.P. Gilbert
Lease Name Dale Well No. 1-13
Office Address 600 East 42nd St. New York, New York
Character of Well (completed as Oil, Gas or Dry Hole) Gas
Date well completed Nov. 10 19 68
Application for plugging filed Aug. 9 19 74
Application for plugging approved Aug. 12 19 74
Plugging commenced Aug. 12 19 74
Plugging completed Aug. 15 10:00 19 74
Reason for abandonment of well or producing formation Not Productive
If a producing well is abandoned, date of last production 8-8 19 74
Was permission obtained from the Conservation Division or its agents before plugging was commenced? Yes

Name of Conservation Agent who supervised plugging of this well Russell Biberstein
Producing formation _____ Depth to top _____ Bottom _____ Total Depth of Well 5177 Feet
Show depth and thickness of all water, oil and gas formations.

OIL, GAS OR WATER RECORDS

CASING RECORD

FORMATION	CONTENT	FROM	TO	SIZE	PUT IN	PULLED OUT
				8 5/8"	520	None
				5 1/2"	5176	3919

Describe in detail the manner in which the well was plugged, indicating where the mud fluid was placed and the method or methods used in introducing it into the hole. If cement or other plugs were used, state the character of same and depth placed, from _____ feet to _____ feet for each plug set.

Dumped in sand from 5176 to 4130

Dumped 5 sacks cement with dump bailer

Cement from 5130 to 5100

Ripped at 4200, 4000 and 3919

Built wood bridge at 240

Rock from 240 to 230

4 yards ready mix to surface

RECEIVED
STATE CORPORATION COMMISSION
AUG 29 1974
8-29-74
CONSERVATION DIVISION
Wichita, Kansas

Name of Plugging Contractor Clarke Corporation
Address Box 187, Medicine Lodge, Kansas 67104

STATE OF Kansas, COUNTY OF Sedgwick, ss.
C. Robert Buford (Employee of owner) or (owner or operator) of the above-described

well, being first duly sworn on oath, says: That I have knowledge of the facts, statements, and matters herein contained and the log of the above-described well as filed and that the same are true and correct. So help me God.

(Signature) C. Robert Buford
200 W. Douglas, Wichita, Kansas 67202
(Address)

SUBSCRIBED AND SWORN TO before me this 26th day of August, 19 74

My commission expires February 4, 1978

Karen K. Morris
Karen K. Morris
Notary Public.

GABBERT-JONES, INC.
WICHITA, KANSAS
DRILLERS' WELL LOG

DALE #1-13
C NW SW Section 13-33S-18W
Comanche County, Kansas

Commenced: October 27, 1968
Completed: November 10, 1968

OPERATOR - Zenith Drilling Corporation, Inc.

RECEIVED
STATE CORPORATION COMMISSION
AUG 12 1974
8-12-74
CONSERVATION DIVISION
Wichita, Kansas

DEPTH		FORMATION	REMARKS
From	To		
0	220	Red bed	
220	450	Sand and red bed	
450	520	Red bed and shale	Ran 13 joints 8-5/8" casing, set @ 520' w/350 sacks cement.
520	800	Red bed and shale	
800	1100	Red bed, shale and shells	
1100	2260	Shale and shells	
2260	4178	Lime and shale	
4178	4377	Lime and sandy shale	
4377	4518	Lime and shale	
4518	5177	Lime	
5177	TD		Ran 158 joints 5-1/2" casing, set @ 5176' w/100 sacks cement.

I, E. E. HALL, certify this is a correct copy of the Drillers' Log for the well drilled in the C NW SW Section 13-33S-18W, Comanche County, Kansas to the best of my knowledge and belief.

E. E. HALL

STATE OF KANSAS)
) SS
COUNTY OF SEDGWICK)

Before me, the undersigned, a Notary Public within and for said County and State, on this 15th day of November, 1968, personally appeared E. E. Hall to me personally known to be the identical person who executed the within and foregoing instrument and acknowledged to me that he executed the same as his free and voluntary act and deed for the uses and purposes therein set forth.

IN WITNESS WHEREOF, I have hereunto set my hand and official seal the day and year last above written.

My Commission Expires Feb. 1, 1972

Barbara J. Layton, Notary Public