


STATE OF KANSAS
STATE CORPORATION COMMISSION

WELL PLUGGING RECORD

Give All Information Completely
Make Required Affidavit
Mail or Deliver Report to
Conservation Division
State Corporation Comm.
245 North Water
Wichita, KS 67202

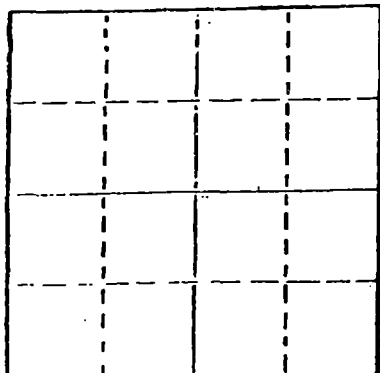

Locate well correctly on above
Section 71st

Comanche County. Sec. 3 Twp. 33S Rge. 18 E/W
Location as "NE/CNW $\frac{1}{4}$ SW $\frac{1}{4}$ " or footage from lines
SW $\frac{1}{4}$ C SW SE
Lease Owner Imperial Oil Company
Lease Name Todd Well No. 1-3
Office Address 720 Fourth Financial Center Wichita, KS 67202
Character of Well (Completed as Oil, Gas or Dry Hole) Dry Hole
Date Well completed 10-05-1980
Application for plugging filed 10-05-1980
Application for plugging approved 10-05-1980
Plugging commenced 10-05-1980
Plugging completed 10-05-1980
Reason for abandonment of well or producing formation Dry Hole
If a producing well is abandoned, date of last production 19

Was permission obtained from the Conservation Division or its agents before plugging was commenced? yes

Name of Conservation Agent who supervised plugging of this well Bill Owens
Producing formation _____ Depth to top _____ Bottom _____ Total Depth of Well 5749
Show depth and thickness of all water, oil and gas formations.

OIL, GAS OR WATER RECORDS

CASING RECORD

FORMATION	CONTENT	FROM	TO	SIZE	PUT IN	PULLED OUT
				8 5/8	575'	

Describe in detail the manner in which the well was plugged, indicating where the mud fluid was placed and the method or methods used in introducing it into the hold. If cement or other plugs were used, state the character of same and depth placed, from _____ feet to _____ feet for each plug set.

50 sacks @ 600
10 sacks @ 40
10 sacks in the rat hole
5 sacks in the mouse hole

(If additional description is necessary, use BACK of this sheet)

Name of Plugging Contractor Eagle Drilling, Inc.

STATE OF Kansas COUNTY OF Sedgwick, ss.
Robert L. Eisel (employee of owner) or (owner or operator)
of the above-described well, being first duly sworn on oath, says: That I have knowledge of the facts, statements, and matters herein contained and the log of the above-described well as filed and that the same are true and correct. So help me God.

(Signature) Robert L. Eisel
260 N. Rock Road Suite 210 Wichita, KS 67206
(Address)

SUBSCRIBED AND SWORN TO before me this 9th day of October, 19 80

Sharon M. Lewis
Sharon M. Lewis Notary Public.

My commission expires August 13, 1983

SHARON M. LEWIS
STATE NOTARY PUBLIC
Sedgwick County, Kansas
My Appt. Expires 08-13-83

RECEIVED
STATE CORPORATION COMMISSION
OCT 10 1980
10-10-80
CONSERVATION DIVISION
Wichita, Kansas

15-033-20373-0000

DRILLER'S LOG

Operator: Imperial Oil Company
Lease Name: Todd #1-3
Spot Location: C SW SE NWSE DMB EE
Sec. 3-33S-18W
County, State: Comanche County, Kansas

Commenced: 09-23-80
Completed: 10-05-80

Surface Casing: Ran 13 joints of 8 5/8" set at 575' K.B. Cemented w/325 sacks Light, 3% cc. Followed w/175 sacks Common, 3% cc. Cement did circulate.

FORMATION

DEPTH

Table with 2 columns: FORMATION and DEPTH. Rows include Red Bed, Shale, Shale & Shells, Shale, Shale & Shells, Shale & Lime, Lime & Shale, Shale & Lime, Lime, Lime & Shale, Lime, and TD.

RECEIVED
STATE CORPORATION COMMISSION
OCT 10 1980
CONSERVATION DIVISION
Wichita, Kansas

I do hereby certify that the foregoing statements are true and correct to the best of my knowledge and belief.

EAGLE DRILLING, INC.

Robert L. Eisel
Vice-President

STATE OF KANSAS)
COUNTY OF SEDGWICK) ss:

Subscribed and sworn to before me this 9th day of October, 1980.

SHARON M. LEWIS
STATE NOTARY PUBLIC
Sedgwick County, Kansas

My appointment expires: Appt. Expires 08-13-83

August 13, 1983

Notary Public

Sharon M. Lewis
Sharon M. Lewis