


WELL PLUGGING RECORD

Give All Information Completely  
Make Required Affidavit  
Mail or Deliver Report to:  
Conservation Division  
State Corporation Commission  
800 Bitting Building  
Wichita, Kansas

NORTH

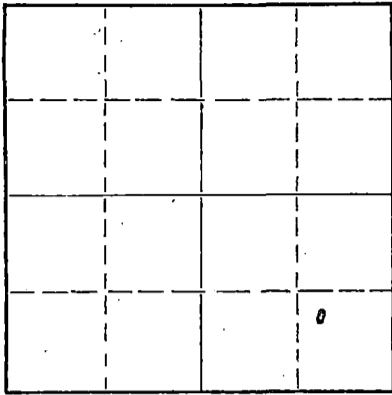

Locate well correctly on above  
Section Plat

Pratt County. Sec. 36 Twp. 26 Rge. (E) 13(W)  
Location as "NE/CNW/SW" or footage from lines NW SE SE  
Lease Owner H. & H. Supply Co.  
Lease Name Harrel A Well No. 7  
Office Address P.O. Box 95226 Oklahoma City, Oklahoma  
Character of Well (completed as Oil, Gas or Dry Hole) oil  
Date well completed 5/31/55 19  
Application for plugging filed 4/21/65 19  
Application for plugging approved 4/22/65 19  
Plugging commenced 5/25/65 19  
Plugging completed ~~5/27/65~~ ~~6/30/65~~ 7/8/65 19  
Reason for abandonment of well or producing formation depleted

If a producing well is abandoned, date of last production 19  
Was permission obtained from the Conservation Division or its agents before plugging was commenced? yes

Name of Conservation Agent who supervised plugging of this well A. Elving  
Producing formation Depth to top Bottom Total Depth of Well Feet  
Show depth and thickness of all water, oil and gas formations.

OIL, GAS OR WATER RECORDS

CASING RECORD

FORMATION	CONTENT	FROM	TO	SIZE	PUT IN	PULLED OUT
				8-5/8"	433'	-0-
				5-1/2"	4327'	2687'

Describe in detail the manner in which the well was plugged, indicating where the mud fluid was placed and the method or methods used in introducing it into the hole. If cement or other plugs were used, state the character of same and depth placed, from feet to feet for each plug set.

Squeezed with 121 sacks cement - Capped well with 15 sacks cement

RECEIVED  
STATE CORPORATION COMMISSION

OCT 22 1965  
10-22-65  
CONSERVATION DIVISION  
WICHITA, KANSAS

(If additional description is necessary, use BACK of this sheet)

Name of Plugging Contractor Gayle E. Toland  
Address P.O. Box 94336 Oklahoma City, Oklahoma

STATE OF OKLAHOMA, COUNTY OF OKLAHOMA, ss.  
T. V. Richardson (employee of owner) or (owner or operator) of the above-described well, being first duly sworn on oath, says: That I have knowledge of the facts, statements, and matters herein contained and the log of the above-described well as filed and that the same are true and correct. So help me God.

(Signature) *T. V. Richardson*

(Address)

SUBSCRIBED AND SWORN TO before me this 21st day of October, 19 65

My commission expires 11/6/66

Notary Public.

15-151-10885-00-00

DRILLERS LOG

Harrel "A" #7

Loc: C/NW-SE-SE  
Sec: 36-268-13W  
Pratt County, Kansas  
Operator: Cooperative Refinery Ass'n.  
Contractor: Company Rig #5

Elevation: 1938 D.F.  
Casing: 8 5/8" @ 433' w/ 300 sq.  
pocmix, (200 sq. 1/2 lb.  
Flocule, 100 sq. 2% C.C)

5 1/2" @ 4327' w/ 175 sq.  
common.

Comm: 5-11-55 Comp: 5-31-55  
Total Depth: 4332 R.T.D.  
(4328 D.F.)

From	To	Formation
0	433	Surface hole
433	775	Redbed, shale, sand
775	907	Anhydrite
907	930	Shale
930	1600	Shale & shells
1600	2580	Shale & lime
2580	2710	Shale & shells
2710	2915	Shale
2915	3428	Shale & lime
3428	3490	Lime
3490	3580	Shale & lime
3580	4080	Lime
4080	4110	Lime & chert
4110	4118	Mississippi
4118	4200	Lime & chert
4200	4332	Lime
4332		R.T.D.

RECEIVED  
STATE CORPORATION COMMISSION

OCT 22 1965

CONSERVATION DIVISION  
Wichita, Kansas

(STATE OF KANSAS )

(COUNTY OF BARTON)

I hereby certify that the above is a true and correct copy of the log on the  
Harrel "A" #7 well, located C/NW-SE-SE of Section 36-268-13W, Pratt County, Kansas.

*P. H. Jenson*

Subscribed and sworn to before me this 1 day of June 1955

*Dorall E. Hunt*

My commission expires: August 17, 1957

15-151-10885-00-00

DRILLING TIME LOG

COMPANY: CRA, Aladdin, Rock Hill

Sec. 36 Twp. 26 Rge. 13W

FARM: Herrel #7

C NW SE SE

ELEVATION: 1942 R.B.

Pratt County, Kansas

Depth		Actual Drilling Time												Remarks
From	To	1' Drilling Time												
3400	3410	5	6	9	12	12	13	14	11	14	11			
3410	3420	10	8	5	5	5	4	4	7	4	4			
3420	3430	4	4	7	8	7	7	6	6	4	3		Trip @ 3428	
3430	3440	3	4	6	5	3	2	5	3	2	2			
3440	3450	4	3	4	4	6	5	3	4	3	2			
3450	3460	2	4	5	4	4	5	4	4	4	4			
3460	3470	5	5	5	3	5	7	6	7	8	7			
3470	3480	4	4	5	3	4	5	2	2	2	1			
3480	3490	1	2	2	4	3	4	4	5	5	3			
3490	3500	4	6	5	4	2	2	2	1	2	2			
3500	3510	2	2	3	2	2	1	2	1	2	2			
3510	3520	1	1	2	3	2	2	3	3	2	2			
3520	3530	3	3	5	5	7	12	8	9	8	5			
3530	3540	5	4	3	3	5	8	6	7	8	8			
3540	3550	2	5	6	4	3	7	10	13	8	6			
3550	3560	5	5	6	6	8	9	8	8	9	9			
3560	3570	5	5	6	6	8	6	10	10	9	8			
3570	3580	5	6	6	4	5	4	4	5	7	7			
3580	3590	5	5	10	6	5	6	4	5	4	6			
3590	3600	5	7	6	5	5	5	6	4	4	3			
3600	3610	4	3	3	7	4	2	5	5	9	7			
3610	3620	8	6	7	7	9	9	8	6	3	6			
3620	3630	4	3	2	2	4	5	4	4	8	4			
3630	3640	7	6	9	5	4	5	5	6	5	5			
3640	3650	3	3	2	2	4	4	6	4	5	5			
3650	3660	7	8	9	9	8	8	8	9	9	9			
3660	3670	11	10	12	12	7	7	10	12	11	11			
3670	3680	10	11	9	10	10	12	11	10	10	9			
3680	3690	10	9	10	10	8	8	4	8	8	8			
3690	3700	9	9	10	9	11	10	7	8	8	8			
3700	3710	8	9	10	10	8	12	5	8	10	9		Trip @ 3706	
3710	3720	9	8	7	7	8	6	5	6	7	6			
3720	3730	5	6	5	7	8	6	7	7	9	9			
3730	3740	8	8	6	7	8	9	8	7	7	7			
3740	3750	6	9	8	10	10	9	9	10	12	10			
3750	3760	12	11	11	11	13	11	9	7	6	7			
3760	3770	6	6	8	7	7	7	7	7	7	8		Good Odor @ 3770	
3770	3780	9	10	10	9	10	11	10	11	12	11		Good Odor @ 3775	
3780	3790	12	8	6	7	7	9	10	9	8	7			
3790	3800	9	9	9	9	7	9	12	14	14	11		S.R. @ 3795	
3800	3810	13	11	11	14	14	10	11	11	8	10		S.R. @ 3816	
3810	3820	10	8	7	9	11	13	14	12	12	16			
3820	3830	16	9	10	15	13	17	5	10	10	14			
3830	3840	11	11	11	16	8	14	12	11	12	11			
3840	3850	10	11	12	13	10	8	8	7	9	14		S.R. @ 3848	
3850	3860	12	16	21	12	13	12	14	9	10	10			
3860	3870	9	9	11	12	14	15	9	9	6	7		Trip @ 3866; Circ. 3861	
3870	3880	14	14	12	11	12	16	14	10	10	6			
3880	3890	7	5	8	8	9	5	7	2	1	4		S.R. @ 3886, 88, 90. L. @ 3889	
3890	3900	13	11	15	17	9	7	9	10	10	5		DST, Circ @ 3891	
3900	3910	6	10	11	11	13	14	15	15	12	15			
3910	3920	14	13	10	11	9	8	8	6	6	11			
3920	3930	11	9	10	6	4	4	4	5	6	5		S.R. @ 3922, 25	
3930	3940	9	13	12	12	11	10	7	2	3	3		S.R. @ 3937, 38. Circ. DST @ 3940	
3940	3950	2	4	4	7	9	11	12	12	11	12			

RECEIVED  
STATE CORPORATION COMMISSION  
OCT 22 1965  
CONSERVATION DIVISION  
Wichita, Kansas

Barrel #7

-2-

3950	3960	11	12	12	12	15	16	20	17	15	12
3960	3970	11	16	16	17	13	7	7	7	14	13
3970	3980	15	15	12	13	12	13	14	13	13	13
3980	3990	18	8	8	10	13	15	15	12	15	15
3990	4000	16	16	17	16	13	15	19	20	20	18
4000	4010	17	19	21	13	12	19	13	11	14	11
4010	4020	27	21	15	11	12	12	7	8	16	12
4020	4030	17	16	15	19	17	17	16	16	14	14
4030	4040	24	16	16	12	16	19	18	10	8	13
4040	4050	16	15	15	15	8	13	11	11	11	13
4050	4060	11	13	13	15	12	16	16	15	16	12
4060	4070	14	20	12	12	13	13	7	6	7	7
4070	4080	5	8	11	10	8	11	8	8	14	12
4080	4090	19	13	13	13	14	11	13	15	15	16
4090	4100	15	16	16	17	16	13	14	14	15	16
4100	4110	14	13	15	14	13	13	11	9	8	12
4110	4120	13	14	14	17	18	16	13	14	11	9
4120	4130	13	12	13	12	16	13	25	11	10	8
4130	4140	9	12	13	13	12	11	8	10	12	11
4140	4150	8	9	8	7	5	5	4	4	3	4
4150	4160	4	4	4	5	4	9	9	10	10	10
4160	4170	11	11	12	9	9	10	10	10	9	10
4170	4180	10	7	7	7	7	5	5	5	4	6
4180	4190	4	4	5	4	4	6	9	7	7	7
4190	4200	6	6	5	5	7	5	6	7	6	7
4200	4210	3	6	5	5	8	6	4	5	6	4
4210	4220	5	5	5	7	7	5	10	11	11	8
4220	4225	7	7	6	11	10					

Trip @ 4013

S.R. @ 4105, 08. V.S.R. @ 4109.  
S.R. @ 4119, 20

S.R. @ 4143, 50. V.S.R. @ 4144, 49.  
R. @ 4151. Circ. @ 4159  
S.R. @ 4165  
S.R. @ 4174, 75, 77, 80. R. @ 4176, 79  
S.R. @ 4181, 82, 83, 84; Trip @ 4176  
R. @ 4193, V.S.R. @ 4185  
95, 96; Circ. @ 4200

Circ. @ 4225

CORE #1 4225-4268

4225	4230	40	30	29	26	20					
4230	4240	14	16	16	20	29	38	37	44	38	35
4240	4250	20	26	43	36	18	23	21	28	25	23
4250	4260	21	24	15	17	15	14	26	32	17	14
4260	4268	13	10	13	16	9	9	10	10		
4268	4270	8	9								
4270	4280	9	10	9	9	8	9	10	12	11	13
4280	4290	14	17	17	15	14	15	15	16	17	17
4290	4300	15	16	16	15	19	14	14	15	13	13
4300	4310	16	16	14	15	16	13	14	16	18	14
4310	4320	14	15	12	13	14	15	15	16	15	16
4320	4330	15	16	16	15	14	15	14	14	14	15
4330	4332	22	23								

Circ. @ 4332

**RECEIVED**  
STATE CORPORATION COMMISSION

OCT 22 1965

CONSERVATION DIVISION  
Wichita, Kansas