


WELL PLUGGING RECORD

Give All Information Completely  
Make Required Affidavit  
Mail or Deliver Report to:  
Conservation Division  
State Corporation Commission  
211 No. Broadway  
Wichita, Kansas

NORTH

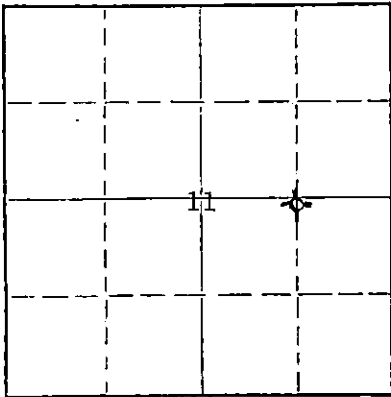

Locate well correctly on above  
Section Plat

Comanche County, Sec. 11 Twp. 33S Rge. (E) 17 (W)  
Location as "NE/CNW/SW" or footage from lines 50' S of C of E/2  
Lease Owner Graham-Michaelis Drilling, Inc.  
Lease Name Einsel Well No. 1-11  
Office Address 211 North Broadway, Wichita, Kansas 67202  
Character of Well (completed as Oil, Gas or Dry Hole) Dry Hole  
Date well completed July 15, 19 67  
Application for plugging filed July 17, 19 67  
Application for plugging approved (verbal) July 15, 19 67  
Plugging commenced July 15, 19 67  
Plugging completed July 15, 19 67  
Reason for abandonment of well or producing formation Dry Hole

If a producing well is abandoned, date of last production none 19\_\_  
Was permission obtained from the Conservation Division or its agents before plugging was commenced? Yes

Name of Conservation Agent who supervised plugging of this well Archie V. Elving  
Producing formation none Depth to top -- Bottom -- Total Depth of Well 5200 Feet  
Show depth and thickness of all water, oil and gas formations.

OIL, GAS OR WATER RECORDS

CASING RECORD

FORMATION	CONTENT	FROM	TO	SIZE	PUT IN	PULLED OUT
				8 5/8"	508'	none

Describe in detail the manner in which the well was plugged, indicating where the mud fluid was placed and the method or methods used in introducing it into the hole. If cement or other plugs were used, state the character of same and depth placed, from feet to feet for each plug set.

Filled hole with heavy drilling mud. Cement plug (35 sacks cement) at 300'.  
Filled hole with heavy drilling mud. Cement plug (10 sacks cement) at 40', to top of casing.

RECEIVED  
STATE CORPORATION COMMISSION

JUL 27 1967

7-27-67

CONSERVATION DIVISION  
Wichita, Kansas


(If additional description is necessary, use BACK of this sheet)

Name of Plugging Contractor Graham-Michaelis Drilling, Inc.  
Address 211 North Broadway, Wichita, Kansas 67202

STATE OF Kansas, COUNTY OF Sedgwick, ss.  
Jack L. Yinger (employee of owner) or (owner or operator) of the above-described well, being first duly sworn on oath, says: That I have knowledge of the facts, statements, and matters herein contained and the log of the above-described well as filed and that the same are true and correct. So help me God.

(Signature) Jack L. Yinger  
Jack L. Yinger - Geologist  
211 North Broadway, Wichita, Kansas 67202  
(Address)

SUBSCRIBED AND SWORN TO before me this 17th day of July, 19 67

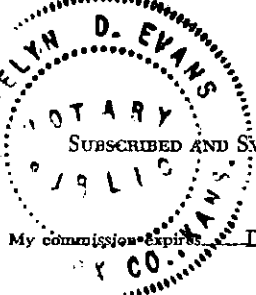

My commission expires December 12, 1970

Evelyn D. Evans  
Notary Public.

ETWEL NO. 1-11

## WELL RECORD:

## LOCATION:

50' S. of C E/2 SW/4 Sec. 11-33S-17W  
Comanche County, Kansas

Commenced: 7-3-67  
Completed: 7-15-67  
(Rotary)

## CONTRACTOR:

Graham-Michaelis Drilling, Inc.  
Liberal Division  
P. O. Box 1294  
Liberal, Kansas 67901

## CASING RECORD:

16 Joints 8-5/8" 24# Casing Set at  
508' - Cemented w/200 sx Sunset on  
bottom w/100 sx on top

	<u>LOG</u>
Surface Sand & Red Bed	0 - 509
Red Bed, Gyp & Sand	509 - 1105
Red Bed	1105 - 1903
Red Bed & Gyp	1903 - 2227
Line & Shale	2227 - 5200

5200' - Total Rotary Depth

The undersigned, Graham-Michaelis Drilling, Inc., Liberal Division, certifies that the above log is a true and correct copy of the formations encountered in drilling the above mentioned well, as taken from the Daily Drilling Report.

GRAHAM-MICHAELIS DRILLING, INC.  
LIBERAL DIVISION

By 

/rw

**RECEIVED**  
STATE CORPORATION COMMISSION

JUL 27 1967

7-27-67

CONSERVATION DIVISION  
Wichita, Kansas