


STATE OF KANSAS
STATE CORPORATION COMMISSION

WELL PLUGGING RECORD

Give All Information Completely
Make Required Affidavit
Mail or Deliver Report to
Conservation Division
State Corporation Comm.
245 North Water
Wichita, KS 67202

Comanche County, Sec. 10 Twp. 33S Rge. 17W E/W
Location as "NE/CNW $\frac{1}{4}$ SW $\frac{1}{4}$ " or footage from lines
C. NW SE

Lease Owner Hummon Corporation
Lease Name Victor Well No. 1
Office Address 400 One Main Place, Wichita, Kansas 67202
Character of Well (Completed as Oil, Gas or Dry Hole) Dry Hole

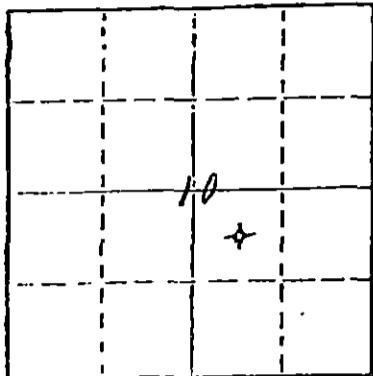

Locate well correctly on above
Section Plot

Date Well completed July 25, 1981
Application for plugging filed July 25, 1981
Application for plugging approved July 25, 1981
Plugging commenced July 25, 1981
Plugging completed July 25, 1981
Reason for abandonment of well or producing formation Dry Hole

If a producing well is abandoned, date of last production 19

Was permission obtained from the Conservation Division or its agents before plugging was commenced? Yes

Name of Conservation Agent who supervised plugging of this well Wm. T. Owen
Producing formation _____ Depth to top _____ Bottom _____ Total Depth of Well 5172'
Show depth and thickness of all water, oil and gas formations.

OIL, GAS OR WATER RECORDS

CASING RECORD

FORMATION	CONTENT	FROM	TO	SIZE	PUT IN	PULLED OUT
		0'	494'	8-5/8"	487.96'	None

Describe in detail the manner in which the well was plugged, indicating where the mud fluid was placed and the method or methods used in introducing it into the hold. If cement or other plugs were used, state the character of same and depth placed, from _____ feet to _____ feet for each plug set.

Plugged with 70 sacks cement at 550';
10 sacks cement at 40'; cemented rat
hole full.

RECEIVED
STATE CORPORATION COMMISSION

(If additional description is necessary, use BACK of this sheet)

Name of Plugging Contractor Allied Cementing Co.

08-05-1981
CONSERVATION DIVISION
Wichita, Kansas


STATE OF KANSAS COUNTY OF SEDGWICK, ss.
John D. Knightley Agent (employee of owner) or (owner or operator)
of the above-described well, being first duly sworn on oath, says: That I have knowledge of the facts, statements, and matters herein contained and the log of the above-described well as filed and that the same are true and correct. So help me God.

(Signature) [Signature]
221 S. Broadway, Suite 400, Wichita, KS 67202
(Address)

SUBSCRIBED AND SWORN TO before me this 4th day of August, 19 81

[Signature] Notary Public.

My commission expires March 12, 1983

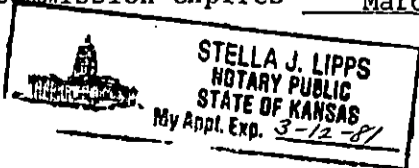

15-033 - 20459-00-00

Hummon Corporation
400 One Main Place
Wichita, Kansas 67202

- Victor #1
C NW SE Sec. 10-33S-17W
Comanche County, Kansas

Contractor: D. R. Lauck Oil Company, Inc.
221 S. Broadway, Suite 400
Wichita, Kansas 67202

Commenced: July 13, 1981
Completed: July 25, 1981

Drillers Log

Clay, Gyp	405
Clay, Red Bed, Shale	1175
Shale & Shells	2005
Shale	3050
Shale & Lime	3215
Shale	3400
Shale & Lime	3960
Lime & Shale	4135
Lime	4190
Lime, Shale & Sand	4335
Lime	4525
Lime & Shale	4765
Lime	4975
Lime & Shale	5001
Lime	5172 RTD

RECEIVED
STATE CORPORATION COMMISSION

AUG 5 1981

CONSERVATION DIVISION
Wichita, Kansas

08-05-1981