

15-033-20564-0000

RECEIVED STATE CORPORATION COMMISSION FORM CP-4
AUG 02 1982
8-7-82
CONSERVATION DIVISION
Wichita, Kansas


STATE OF KANSAS
STATE CORPORATION COMMISSION

WELL PLUGGING RECORD

Give All Information Completely
Make Required Affidavit
Mail or Deliver Report to
Conservation Division
State Corporation Comm.
245 North Water
Wichita, KS 67202

Comanche County. Sec. 12 Twp. 33S Rge. 17 E/W
Location as "NE/CNW $\frac{1}{4}$ SW $\frac{1}{4}$ " or footage from lines
660' FWL & 660' FSL

Lease Owner J. M. Huber Corporation
Lease Name Einsel-Biddle Well No. 4
Office Address 2212 N.W. 50th, Suite 246, Oklahoma City, OK
Character of Well (Completed as Oil, Gas or Dry Hole) 73112
Dry Hole

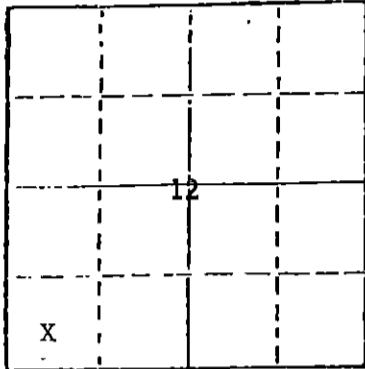

Locate well correctly on above
Section Plot

Date Well completed July 6, 1982
Application for plugging filed July 19, 1982
Application for plugging approved July 6, 1982
Plugging commenced July 6, 1982
Plugging completed July 6, 1982
Reason for abandonment of well or producing formation

Non-commercial
If a producing well is abandoned, date of last production
19

Was permission obtained from the Conservation Division or
its agents before plugging was commenced? yes

Name of Conservation Agent who supervised plugging of this well Marion Schmidt
Producing formation None Depth to top Bottom Total Depth of Well 5235'
Show depth and thickness of all water, oil and gas formations.

OIL, GAS OR WATER RECORDS

CASING RECORD

FORMATION	CONTENT	FROM	TO	SIZE	PUT IN	PULLED OUT
None				20"	56'	-0-
				8 5/8"	619.08'	-0-

Describe in detail the manner in which the well was plugged, indicating where the mud fluid was placed and the method or methods used in introducing it into the hold. If cement or other plugs were used, state the character of same and depth placed, from feet to feet for each plug set. Set 80 sx cmt plug with Howco 50-50 poz with 4% gel & 3% CaCl from 720' to 435'. Set 40 sx plug 270' to 130' & 10 sx plug with 1/2# /SK hulls from 40' to 3' BGL. Cut off surface csg 3' BGL & welded steel cap. Plug instruments per Mr. Marion Schmidt with KCC. Filled rathole with 10 sx cmt.

(If additional description is necessary, use BACK of this sheet)

Name of Plugging Contractor Rains & Williamson

STATE OF Oklahoma COUNTY OF Oklahoma, ss.
Paul M. Walker (employee of owner) or (owner/owner's representative)
of the above-described well, being first duly sworn on oath, says: That I have knowledge of the facts, statements, and matters herein contained and the log of the above-described well as filed and that the same are true and correct. So help me God.

(Signature) Paul M. Walker
2212 N.W. 50th, Suite 246, Okla. City, OK 73112
(Address)

SUBSCRIBED AND SWORN TO before me this 29th day of July, 1982

Jue Lampton
Notary Public.

My commission expires 1-18-84