

15-033-20460-00-00


STATE OF KANSAS  
STATE CORPORATION COMMISSION

WELL PLUGGING RECORD

Give All Information Completely  
Make Required Affidavit  
Mail or Deliver Report to  
Conservation Division  
State Corporation Comm.  
245 North Water  
Wichita, KS 67202

Comanche County, Sec. 3 Twp. 33S Rge. 17W E/W  
Location as "NE/CNW $\frac{1}{4}$ SW $\frac{1}{4}$ " or footage from lines  
C NW SE

Lease Owner Hummon Corporation  
Lease Name Victor Well No. 2  
Office Address 400 One Main Place, Wichita, Kansas 67202  
Character of Well (Completed as Oil, Gas or Dry Hole)  
Dry Hole

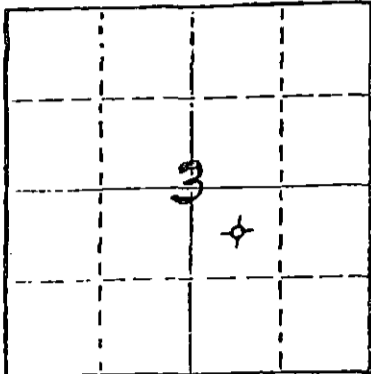

Locate well correctly on above  
Section Plat

Date Well completed August 8, 1981  
Application for plugging filed August 8, 1981  
Application for plugging approved August 8, 1981  
Plugging commenced August 8, 1981  
Plugging completed August 8, 1981  
Reason for abandonment of well or producing formation  
Dry Hole

If a producing well is abandoned, date of last production  
19

Was permission obtained from the Conservation Division or  
its agents before plugging was commenced? Yes

Name of Conservation Agent who supervised plugging of this well Wm. T. Owen  
Producing formation \_\_\_\_\_ Depth to top \_\_\_\_\_ Bottom \_\_\_\_\_ Total Depth of Well 5215'  
Show depth and thickness of all water, oil and gas formations.

OIL, GAS OR WATER RECORDS

CASING RECORD

FORMATION	CONTENT	FROM	TO	SIZE	PUT IN	PULLED OUT
		0'	453'	8-5/8"	446.30'	None

Describe in detail the manner in which the well was plugged, indicating where the mud fluid  
was placed and the method or methods used in introducing it into the hold. If cement or other  
plugs were used, state the character of same and depth placed, from \_\_\_\_\_ feet to  
\_\_\_\_\_ feet for each plug set.

Plugged with 50 sacks cement at 450';  
10 sacks cement at 40'; and 10 sacks cement  
in rat hole.

RECEIVED  
STATE CORPORATION COMMISSION  
08-24-1981  
AUG 24 1981  
CONSERVATION DIVISION  
Wichita, Kansas

(If additional description is necessary, use BACK of this sheet)

Name of Plugging Contractor Allied Cementing Co.

STATE OF KANSAS COUNTY OF SEDGWICK, ss.  
John H. Knightley Agent (employee of owner) or (owner or operator)  
of the above-described well, being first duly sworn on oath, says: That I have knowledge of  
the facts, statements, and matters herein contained and the log of the above-described well  
as filed and that the same are true and correct. (So help me God.)

(Signature)

*John H. Knightley*  
221 S. Broadway, Wichita, Kansas 67202  
(Address)



SUBSCRIBED AND SWORN TO before me this 20th day of August, 1981

*Stella J. Lipp*  
Notary Public.

My commission expires March 12, 1983

15-033-20460-00-00

Hummon Corporation  
400 One Main Place  
Wichita, Kansas 67202

-

Victor #2  
C NW SE Sec. 3-33S-17W  
Comanche County, Kansas

Contractor: D. R. Lauck Oil Company, Inc.  
221 S. Broadway, Suite 400  
Wichita, Kansas 67202

Commenced: July 26, 1981  
Completed: August 8, 1981

Drillers Log

Red Bed & Clay	870
Red Bed, Clay & Shale	1670
Shale	2043
Shale & Shells	2325
Shells & Shale	2580
Shale	3190
Shale & Lime	3750
Lime	4030
Shale & Lime	4220
Lime & Shale	4575
Shale & Lime	4820
Lime	5215 RTD

RECEIVED  
STATE CORPORATION COMMISSION

AUG 24 1981

CONSERVATION DIVISION  
Wichita, Kansas

08-24-1981