

STATE OF KANSAS
STATE CORPORATION COMMISSION

WELL PLUGGING RECORD

Give All Information Completely
Make Required Affidavit
Mail or Deliver Report to
Conservation Division
State Corporation Comm.
245 North Water
Wichita, KS 67202

Comanche County, Sec. 4 Twp. 33S Rge. 17 E/W
Location as "NE/CNW $\frac{1}{4}$ SW $\frac{1}{4}$ " or footage from lines
C SE SE


Lease Owner Harper Oil Company
Lease Name Deewall Well No. 1
Office Address 904 Hightower Bldg, Oklahoma City, Okla 73102
Character of Well (Completed as Oil, Gas or Dry Hole)
Dry Hole

Date Well completed February 8 1977
Application for plugging filed March 22 1977
Application for plugging approved March 25 1977
Plugging commenced March 23 1977
Plugging completed March 25 1977
Reason for abandonment of well or producing formation
Dry Hole

If a producing well is abandoned, date of last production
N/A 19

Was permission obtained from the Conservation Division or
its agents before plugging was commenced? Yes

Name of Conservation Agent who supervised plugging of this well Jasper H. Metz
Producing formation Mississippi Depth to top 5120 Bottom 5160 Total Depth of Well 5330
Show depth and thickness of all water, oil and gas formations.

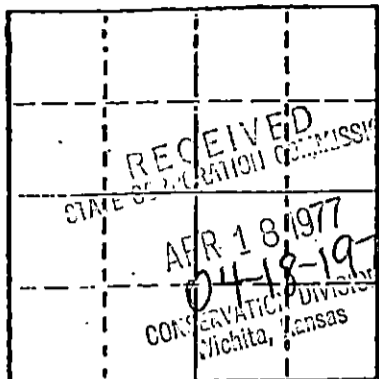

Locate well correctly on above
Section Plat

OIL, GAS OR WATER RECORDS

CASING RECORD

FORMATION	CONTENT	FROM	TO	SIZE	PUT IN	PULLED OUT
Mississippi	trace oil&gas	5120	5160	5 $\frac{1}{2}$ " 11#	5329	3436'
Lansing	water	4648	4660	5 $\frac{1}{2}$ " 11#	5329'	3436'

Describe in detail the manner in which the well was plugged, indicating where the mud fluid was placed and the method or methods used in introducing it into the hold. If cement or other plugs were used, state the character of same and depth placed, from _____ feet to _____ feet for each plug set. A cast iron bridge plug was set at 5095' and 3 sacks of neat cement was placed on top of the plug. Then 25 sacks of neat cement was placed over the interval 4350-4550 feet and the 5 $\frac{1}{2}$ " 11# casing was cut off at 3436 feet. This casing was pulled out of the hole and a cement plug was put in place.

(If additional description is necessary, use BACK of this sheet)

Name of Plugging Contractor Toland & Johnston, Inc.

STATE OF Oklahoma COUNTY OF Oklahoma, ss.
(employee of owner) or (owner or operator)
of the above-described well, being first duly sworn on oath, says: That I have knowledge of the facts, statements, and matters herein contained and the log of the above-described well as filed and that the same are true and correct. So help me God.

(Signature) [Signature], V.P.
904 Hightower Bldg, Oklahoma City, Okla 73102
(Address)

SUBSCRIBED AND SWORN TO before me this 30 day of March, 1977

[Signature]
Notary Public.

My commission expires _____
My Commission Expires Sept. 29, 1980