

15-033-20030-0000

STATE OF KANSAS
STATE CORPORATION COMMISSION


Form CP-4

Give All Information Completely
Make Required Affidavit
Mail or Deliver Report to:
Conservation Division
State Corporation Commission
212 No. Market
Wichita, Kansas

WELL PLUGGING RECORD

Commanche County, Sec. 4 Twp. 34S Rge. 16W (E) (W)
C NW SW

Location as "NE/CNW/SW" or footage from lines.
Lease Owner Shenandoah Oil Corporation
Lease Name Merrill Ranch Well No. C-1
Office Address 1018 Commerce Bldg., Ft. Worth, Texas
Character of Well (completed as Oil, Gas or Dry Hole) Oil Well
Date well completed _____ 19____
Application for plugging filed December 17, 19 69
Application for plugging approved December 22, 19 69
Plugging commenced 2-11 19 70
Plugging completed 2-15 19 70
Reason for abandonment of well or producing formation Non-commercial

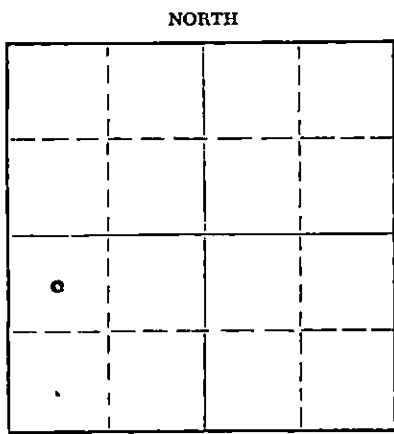

Locate well correctly on above Section Plat

If a producing well is abandoned, date of last production _____ 19____
Was permission obtained from the Conservation Division or its agents before plugging was commenced? Yes

Name of Conservation Agent who supervised plugging of this well Herman Justus, Box 71, Nickerson, Kansas
Producing formation Mississippi Depth to top 4895 Bottom 4910 Total Depth of Well 5098 Feet
Show depth and thickness of all water, oil and gas formations.

OIL, GAS OR WATER RECORDS

CASING RECORD

FORMATION	CONTENT	FROM	TO	SIZE	PUT IN	PULLED OUT
				13-3/8"	97'	None
				8-5/8"	427'	None
				4-1/2"	5071'	3597.30'

Describe in detail the manner in which the well was plugged, indicating where the mud fluid was placed and the method or methods used in introducing it into the hole. If cement or other plugs were used, state the character of same and depth placed, from _____ feet to _____ feet for each plug set.

A 10 sack cement plug was pumped to 4511 feet with mud laden fluid. Pipe was shot free at 3600 feet and pulled up to 300 feet. A 100 sack cement plug was pumped and circulated to surface. Finished pulling pipe.

RECEIVED
STATE CORPORATION COMMISSION
MAR 18 1970
CONSERVATION DIVISION
Wichita, Kansas

(If additional description is necessary, use BACK of this sheet)
Name of Plugging Contractor Clyde A. Reeves & Son, Inc.
Address P. O. Box 94204, Oklahoma City, Oklahoma

STATE OF Texas COUNTY OF Tarrant, ss.
R. L. Nabbefeld (employee of owner) or (owner or operator) of the above-described well, being first duly sworn on oath, says: That I have knowledge of the facts, statements, and matters herein contained and the log of the above-described well as filed and that the same are true and correct. So help me God.

(Signature) [Signature]
1500 Commerce Bldg., Fort Worth, Texas 76102
(Address)

SUBSCRIBED AND SWORN TO before me this 12th day of March, 19 70

Connie L. Bulmer
Notary Public.

My commission expires 6-1-71