

This form shall be filed in duplicate with the Kansas Corporation Commission, 200 Colorado Derby Building, Wichita, Kansas 67202, within ten days after the completion of the well, regardless of how the well was completed.

Attach separate letter of request if the information is to be held confidential. If confidential, only file one copy. Information on side one will be of public record and side two will then be held confidential.

Circle one: Oil, Gas, Dry, SWD, OWWO, Injection. Type and complete ALL sections. Applications must be filed for dual completion, commingling, SWD and injection, T.A.

Attach wireline logs (i.e. electrical log, sonic log, gamma ray neutron log, etc.). KCC # (316) 263-3238. (Rules 82-2-105 & 82-2-125)

OPERATOR Gould Oil, Inc., & Logo, Inc.

API NO. 15-033-20,513-0000

ADDRESS P.O. Box 8640

COUNTY Comanche

Wichita, KS 67208

FIELD N/A

\*\*CONTACT PERSON Dale P. Jewett

PROD. FORMATION N/A

PHONE 316 682-5523

LEASE Jobe

PURCHASER N/A

WELL NO. #1

ADDRESS N/A

WELL LOCATION 100' E of C NW/4 NW/4.

N/A

660' Ft. from North Line and

DRILLING Eagle Drilling, Inc.

760' Ft. from West Line of

CONTRACTOR

ADDRESS P.O. Box 8609

the SEC. 21 TWP. 33 RGE. 17W

Wichita, KS 67208

RECEIVED

WELL PLAT

PLUGGING Clarence Thomas, State Plugger

CONTRACTOR

ADDRESS Garden City, Kansas

DEC 17 1981


12-17-81

CONSERVATION DIVISION  
Wichita, Kansas

Finney County 316 275-1807

KCC  
KGS  
(Office Use)

TOTAL DEPTH 6049' PBD

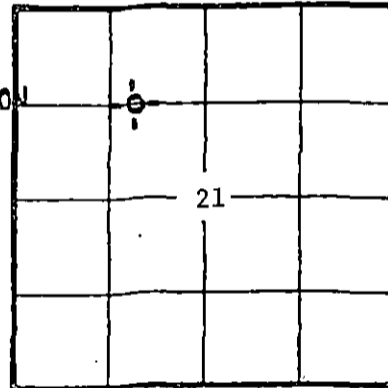

SPUD DATE 11-20-81 DATE COMPLETED 12-04-81

ELEV: GR 1891' DF KB 1904'

DRILLED WITH (CABLE) ROTARY (AIR) TOOLS

Amount of surface pipe set and cemented 524'

DV Tool Used? N/A

A F F I D A V I T

STATE OF Kansas, COUNTY OF Sedgwick SS, I, Dale P. Jewett

OF LAWFUL AGE, BEING FIRST DULY SWORN UPON HIS OATH,

DEPOSES THAT HE IS Vice President (FOR)(OF) Gould Oil, Inc

OPERATOR OF THE Jobe LEASE, AND IS DULY AUTHORIZED TO MAKE

THIS AFFIDAVIT FOR AND ON THE BEHALF OF SAID OPERATOR, THAT WELL NO. #1 ON

SAID LEASE HAS BEEN COMPLETED AS OF THE 4th DAY OF December, 19 81, AND THAT

ALL INFORMATION ENTERED HEREIN WITH RESPECT TO SAID WELL IS TRUE AND CORRECT.

FURTHER AFFIANT SAITH NOT.

TONI K. HALSTEAD  
NOTARY PUBLIC  
STATE OF KANSAS  
MY APPT. EXPIRES 06-17-85

(S) [Signature]

SUBSCRIBED AND SWORN BEFORE ME THIS 16th DAY OF December

RECEIVED  
STATE CORPORATION COMMISSION  
19 81

Toni K. Halstead  
NOTARY PUBLIC  
CONSERVATION DIVISION  
Wichita, Kansas

MY COMMISSION EXPIRES: June 17, 1985

\*\*The person who can be reached by phone regarding any questions concerning this information. Within 45 days of completion, a witnessed initial test by the Commission is required if the well produces more than 25 BOPD or is located in a Basic Order Pool.