

STATE OF KANSAS
STATE CORPORATION COMMISSION

WELL PLUGGING RECORD

Give All Information Completely
Make Required Affidavit
Mail or Deliver Report to
Conservation Division
State Corporation Comm.
245 North Water
Wichita, KS 67202

Comanche County. Sec. 12 Twp. 33S Rge. 17W E/W
Location as "NE/CNW/SW" or footage from lines
1320' FNL & 660' FWL

Lease Owner J. M. Huber Corporation
Lease Name Einsel Riddle Well No. 2

Office Address 2450 Liberty Tower, Okla. City, Ok. 73102
Character of Well (Completed as Oil, Gas or Dry Hole)

Gas

Date Well completed February 23 1965

Application for plugging filed January 9 1978

Application for plugging approved January 12 1978


Plugging commenced March 7 1978

Plugging completed March 10 1978

Reason for abandonment of well or producing formation Well
depleted in producing interval w/no add'l prospective zones.

If a producing well is abandoned, date of last production
July 1977

Was permission obtained from the Conservation Division or
its agents before plugging was commenced? yes

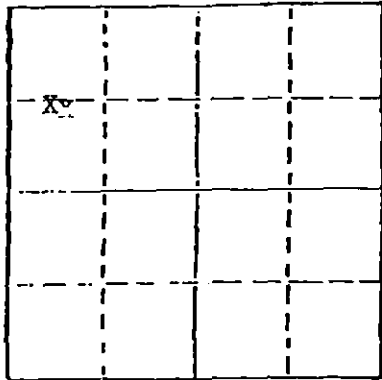

Locate well correctly on above
Section Plat

Name of Conservation Agent who supervised plugging of this well Ray Owen
Producing formation Mississippian Depth to top 5076' Bottom 5126' Total Depth of Well 5200'
Show depth and thickness of all water, oil and gas formations.

OIL, GAS OR WATER RECORDS

CASING RECORD

FORMATION	CONTENT	FROM	TO	SIZE	PUT IN	PULLED OUT
Heebner	Shale-Tight	4204	4254	8-5/8"	405'	0
Douglas	SS&Sh-Tight	4254	4400			
Lansing-KC	LS-Tight	4400	4817	4-1/2"	5199'	4200'
Marmaton	LS-Tight Water	4838	5017			
Cherokee	LS-Tight	5017	5076			
Mississippian	Oil & Gas	5076	5126			

Describe in detail the manner in which the well was plugged, indicating where the mud fluid
was placed and the method or methods used in introducing it into the hold. If cement or other
plugs were used, state the character of same and depth placed, from _____ feet to
_____ feet for each plug set.

Lillard Casing Pullers moved in and spotted a 35 sack cement plug from 4990' to 4585'.
Displaced cement with drilling mud. Shot off 4-1/2" casing at 4200' and pulled 135
joints of 4-1/2" casing. Spotted 50 sack cement plug from 455 to 355' ran wireline and
cement had gone down to 996'. Bridged hole at 447' and cemented from 447 to 3' with 9
yards of readymix cement. Cut off surface casing 3' below ground level and welded on
a steel cap.

(If additional description is necessary, use BACK of this sheet)

Name of Plugging Contractor Lillard Casing Pullers, Inc., P. O. Box 962, Woodward, Ok. 73801

STATE OF Oklahoma COUNTY OF Cleveland, ss.
Larry E. Gateley (employee of owner) or (owner or operator)
of the above-described well, being first duly sworn on oath, says: That I have knowledge of
the facts, statements, and matters herein contained and the log of the above-described well
as filed and that the same are true and correct. So help me God.

(Signature) Larry E. Gateley
2450 Liberty Tower, Okla. City, Okla. 73102
(Address)

SUBSCRIBED AND SWORN TO before me this 15th day of May, 1978

My commission expires My Commission Expires Oct. 28, 1978

Betty J. Twist Notary Public.

RECEIVED
STATE CORPORATION COMMISSION

MAY 18 1978
5-18-78
CONSERVATION DIVISION
WICHITA, KANSAS