

15-033-01004-0000


Comm

STATE OF KANSAS
STATE CORPORATION COMMISSION

Give All Information Completely
Make Required Affidavit
Mail or Deliver Report to:
Conservation Division
State Corporation Commission
800 Bitting Building
Wichita, Kansas

WELL PLUGGING RECORD

NORTH

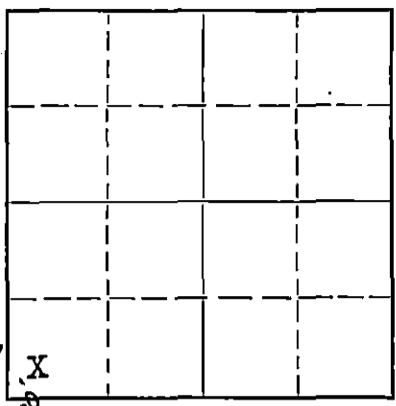

330'
330'

Locate well correctly on above
Section Plat

Comanche County. Sec. 30 Twp. 34 Rge. 19 ^{CEX} (W)
Location as "NE/CNW $\frac{1}{4}$ SW $\frac{1}{4}$ " or footage from lines Cen SW/4 SW/4 SW/4
Lease Owner J.M. Huber Corp.
Lease Name Lemon-Barbee Well No. 1
Office Address Box 978 Liberal, Kansas
Character of Well (completed as Oil, Gas or Dry Hole) Dry Hole
Date well completed 11-2-53 19
Application for plugging filed 11-3-53 19
Application for plugging approved 11-3-53 19
Plugging commenced 11-3-53 19
Plugging completed 11-3-53 19
Reason for abandonment of well or producing formation Dry Hole

If a producing well is abandoned, date of last production 19
Was permission obtained from the Conservation Division or its agents before plugging was commenced? Yes

Name of Conservation Agent who supervised plugging of this well M.A. Rives
Producing formation Depth to top Bottom Total Depth of Well 6590' Feet
Show depth and thickness of all water, oil and gas formations.

OIL, GAS OR WATER RECORDS

CASING RECORD

Formation	Content	From	To	Size	Put In	Pulled Out
				16"	120'	None
				13 3/8"	495'	None

Describe in detail the manner in which the well was plugged, indicating where the mud fluid was placed and the method or methods used in introducing it into the hole. If cement or other plugs were used, state the character of same and depth placed, from feet to feet for each plug set.

Filled hole with mud from 6590' to 400'. Set cementing plug 1 sack of hulls and 35 sacks of cement at 495'. Filled with mud from 400' to 20'. Set cementing plug and 1 sack of hulls at 20'. Filled to surface with 15 sacks of cement.

RECEIVED
STATE CORPORATION COMMISSION
NOV 7 1953
11-13-53
CONSERVATION DIVISION
Wichita, Kansas

(If additional description is necessary, use BACK of this sheet)
Name of Plugging Contractor J.M. Huber Corp.
Address Box 978 Liberal, Kansas

STATE OF KANSAS, COUNTY OF SEWARD, ss.
R.E. McDaniel (employee of owner) or (owner/proprietor) of the above-described well,

being first duly sworn on oath, says: That I have knowledge of the facts, statements, and matters herein contained and the log of the above-described well as filed and that the same are true and correct. So help me God.

(Signature) R.E. McDaniel

Box 978 Liberal, Kansas (Address)

SUBSCRIBED AND SWORN TO before me this 10 day of November, 1953

J. L. Tyler Notary Public.

My commission expires July 27, 1957

PLUGGING
FILE SEC 30 T 34 R 19W
BOOK PAGE 140 LINE 29

23-8390-3 6-51-20M

WELL LOG

Well name: J.M. Huber #1 Lemon-Barbee
 Well location: Cen. SW/4 SW/4 SW/4 Sec 30, Twp 34S, Rge 19W
 Commanche Co., Kansas
 Date commenced: 9-24-53
 Date completed: 11-2-53
 Total Depth: 6590'.
 Character of well: Dry hole.

FORMATION

DEPTH

Surface sand and clay	0-128'
Clay, shale and shells	128-945'
Red bed, shale and shells	945-1975'
Lime and shale	1975-4410'
Lime	4410-4760'
Lime and shale	4760-4815'
Lime	4815-5188'
Lime and shale	5188-5222'
Lime	5222-5514'
Lime and shale	5514-5665'
Lime	5665-5822'
Lime and shale	5822-5864'
Lime	5864-6148'
Lime and chert	6148-6217'
Cherty lime and shale	6217-6289'
Lime and chert	6289-6379'
Sandy lime	6379-6425'
Lime and shale	6425-6590'

Total Depth 6590'.

STATE OF KANSAS, COUNTY OF SEWARD, ss. 11-13-53

R.E. McDaniel employee of owner of the above-described well, being first duly sworn on oath, says: That I have knowledge of the facts, statements and matters herein contained and the log of the above-described well as filed and that the same are true and correct.

R.E. McDaniel

Subscribed and Sworn to before me this 10 day of Nov. 1953

J. L. Ryker
 Notary Public

My commission expires 7-27-57

PLUGGING
 FILE SEC 30 T 34 R 19a
 BOOK PAGE 140 LINE 29