

STATE OF KANSAS
STATE CORPORATION COMMISSION

Give All Information Completely
Make Required Affidavit
Mail or Deliver Report to:
Conservation Division
State Corporation Commission
211 No. Broadway
Wichita, Kansas

WELL PLUGGING RECORD

Comanche County, Sec. 7 Twp. 34S Rge. (E) 17W (W)

Location as "NE/CNW%SW%" or footage from lines C SE/4 SE/4

Lease Owner Braden Drilling, Inc.

Lease Name Hadley Well No. 1

Office Address 1206 Union National Bldg., Wichita, Kansas

Character of Well (completed as Oil, Gas or Dry Hole) Dry Hole

Date well completed April 9, 1963 19 63

Application for plugging filed April 9 19 63

Application for plugging approved April 9 19 63


Plugging commenced April 9 19 63

Plugging completed April 9 19 63

Reason for abandonment of well or producing formation Dry hole

If a producing well is abandoned, date of last production 19

Was permission obtained from the Conservation Division or its agents before plugging was commenced? yes

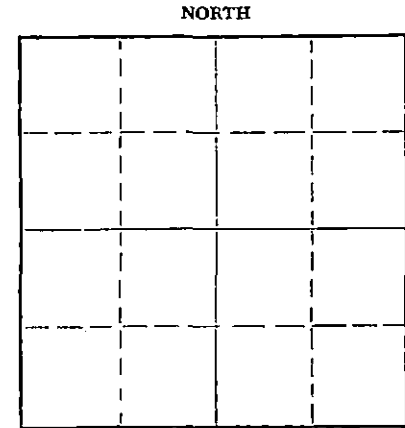

Locate well correctly on above Section Plat

Name of Conservation Agent who supervised plugging of this well Archie V. Elving

Producing formation Depth to top Bottom Total Depth of Well 5900 Feet

Show depth and thickness of all water, oil and gas formations.

OIL, GAS OR WATER RECORDS

CASING RECORD

FORMATION	CONTENT	FROM	TO	SIZE	PUT IN	PULLED OUT
		0	400	8 5/8	400	none

Describe in detail the manner in which the well was plugged, indicating where the mud fluid was placed and the method or methods used in introducing it into the hole. If cement or other plugs were used, state the character of same and depth placed, from feet to feet for each plug set.

Filled hole with mud. Plug at 240' with 1/4 sx hulls and 20 sacks cement. Fill to 40' with mud and 10 sacks cement.

RECEIVED
STATE CORPORATION COMMISSION

APR 18 1963
4-18-63
CONSERVATION DIVISION
Wichita, Kansas

(If additional description is necessary, use BACK of this sheet)

Name of Plugging Contractor Braden Drilling, Inc.

Address 1206 Union National Bldg., Wichita, Kansas

STATE OF Kansas, COUNTY OF Sedgwick, ss.

F. M. Callaway (employee of owner) or (owner or operator) of the above-described well, being first duly sworn on oath, says: That I have knowledge of the facts, statements, and matters herein contained and the log of the above-described well as filed and that the same are true and correct. So help me God.

(Signature) [Signature] 1206 Union National Bldg., Wichita, Kansas (Address)

SUBSCRIBED AND SWORN TO before me this 11th day of April, 19 63

My commission expires March 21, 1966

[Signature] Notary Public.

