


STATE OF KANSAS  
STATE CORPORATION COMMISSION

WELL PLUGGING RECORD

Give All Information Completely  
Make Required Affidavit  
Mail or Deliver Report to  
Conservation Division  
State Corporation Comm.  
245 North Water  
Wichita, KS 67202

Comanche County, Sec. 2 Twp. 34S Rge. 19W E/W  
Location as "NE/CNW $\frac{1}{2}$ SW $\frac{1}{2}$ " or footage from lines

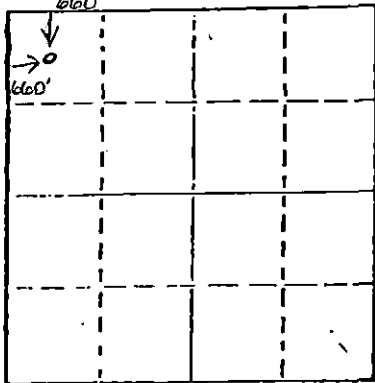

Locate well correctly on above  
Section Plat

Lease Owner Lear Petroleum Exploration  
Lease Name Brass Well No. 1-2  
Office Address 2601 N.W. Expressway, Okla. City, OK 73112  
Character of Well (Completed as Oil, Gas or Dry Hole)

Dry Hole  
Date Well completed 5/27/80 19  
Application for plugging filed 5/27/80 19  
Application for plugging approved 19  
Plugging commenced 5/27/80 19  
Plugging completed 5/27/80 19  
Reason for abandonment of well or producing formation

Dry Hole  
If a producing well is abandoned, date of last production 19

Was permission obtained from the Conservation Division or its agents before plugging was commenced? No

Name of Conservation Agent who supervised plugging of this well  
Producing formation \_\_\_\_\_ Depth to top \_\_\_\_\_ Bottom \_\_\_\_\_ Total Depth of Well \_\_\_\_\_  
Show depth and thickness of all water, oil and gas formations.

OIL, GAS OR WATER RECORDS

CASING RECORD

FORMATION	CONTENT	FROM	TO	SIZE	PUT IN	PULLED OUT

Describe in detail the manner in which the well was plugged, indicating where the mud fluid was placed and the method or methods used in introducing it into the hold. If cement or other plugs were used, state the character of same and depth placed, from 750 feet to Surface feet for each plug set.

Hole was full of 9# mud prior to setting cmt plug as follows:

- 50 sx @ 750'
- 40 sx @ 300'
- 10 sx @ 40'
- 5 sx in rat hole

RECEIVED  
STATE CORPORATION COMMISSION  
JUN - 3 1980  
6-3-80  
CONSERVATION DIVISION  
Wichita, Kansas

(If additional description is necessary, use BACK of this sheet)

Name of Plugging Contractor Thomas Drilling Co.

STATE OF Oklahoma COUNTY OF Oklahoma, ss.  
Lear Petroleum Exploration (employee of owner) or (owner or operator)  
of the above-described well, being first duly sworn on oath, says: That I have knowledge of the facts, statements, and matters herein contained and the log of the above-described well as filed and that the same are true and correct. So help me God.

(Signature) [Signature]  
2601 Northwest Expressway, OKLA. CITY, OK  
(Address)

SUBSCRIBED AND SWORN TO before me this 2nd day of June, 1980

[Signature]  
Notary Public.

My commission expires 2/19/84