


STATE OF KANSAS  
STATE CORPORATION COMMISSION

WELL PLUGGING RECORD

Give All Information Completely  
Make Required Affidavit  
Mail or Deliver Report to  
Conservation Division  
State Corporation Comm.  
245 North Water  
Wichita, KS 67202

Comanche County. Sec. 16 Twp. 34S Rge 18W  
Location as "NE/CNW $\frac{1}{4}$ SW $\frac{1}{4}$ " or footage from lines \_\_\_\_\_

C NE/4  
Lease Owner Mid-Continent Energy Corporation  
Lease Name Deewall Well No. 2  
Office Address One Twenty Bldg., Suite 712, Wichita, Ks.  
Character of Well (Completed as Oil, Gas or Dry Hole) \_\_\_\_\_

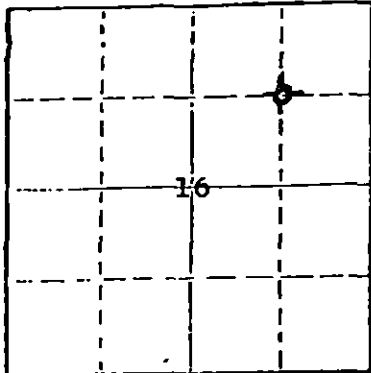

Locate well correctly on above  
Section Plat

Dry Hole  
Date Well completed March 6, 1979  
Application for plugging filed March 6, 1979  
Application for plugging approved March 6, 1979  
Plugging commenced March 6, 1979  
Plugging completed March 6, 1979  
Reason for abandonment of well or producing formation \_\_\_\_\_

Dry Hole  
If a producing well is abandoned, date of last production \_\_\_\_\_ 19\_\_\_\_

Was permission obtained from the Conservation Division or its agents before plugging was commenced? Yes

Name of Conservation Agent who supervised plugging of this well Wm. T. Owen  
Producing formation \_\_\_\_\_ Depth to top \_\_\_\_\_ Bottom \_\_\_\_\_ Total Depth of Well 5375'  
Show depth and thickness of all water, oil and gas formations.

OIL, GAS OR WATER RECORDS

CASING RECORD

FORMATION	CONTENT	FROM	TO	SIZE	PUT IN	PULLED OUT
		0'	405'	8-5/8"	398.19'	None

Describe in detail the manner in which the well was plugged, indicating where the mud fluid was placed and the method or methods used in introducing it into the hold. If cement or other plugs were used, state the character of same and depth placed, from \_\_\_\_\_ feet to \_\_\_\_\_ feet for each plug set.

Plugged with 50 sacks cement at 720',  
40 sacks cement at 390', 12 sacks cement  
and bridge plug at 40', and 3 sacks cement  
in rat hole.

RECEIVED  
STATE CORPORATION COMMISSION  
MAR 21 1979  
CONSERVATION DIVISION  
Wichita, Kansas

(If additional description is necessary, use BACK of this sheet)  
Name of Plugging Contractor Halliburton Cementing Company

STATE OF KANSAS COUNTY OF SEDGWICK, ss.  
John D. Knightley Agent (employee of owner) or (owner or operator)  
of the above-described well, being first duly sworn on oath, says: That I have knowledge of the facts, statements, and matters herein contained and the log of the above-described well as filed and that the same are true and correct. So help me God.

(Signature) [Signature]  
221 S. Broadway, Wichita, Ks. 67202  
(Address)

My commission expires March 12, 1983



Stella J. Lipp  
Notary Public.

Mid-Continent Energy Corporation -  
 One Twenty Building, Suite 712  
 Wichita, Kansas 67202

Deewall #2  
 C NE/4 Sec. 16-34S-18W  
 Comanche County, Kansas

Contractor: D. R. Lauck Oil Company, Inc.  
 221 S. Broadway, Suite 400  
 Wichita, Kansas 67202

Commenced: February 18, 1979  
 Completed: March 6, 1979

Drillers Log

Red Bed	105
Shale	335
Gyp	350
Shale & Gyp	365
Shale	1280
Shale & Shells	2060
Shale & Lime	2260
Lime	2635
Lime & Shale	2910
Lime	5065
Lime & Shale	5170
Lime	5375 RTD

RECEIVED  
 STATE CORPORATION COMMISSION  
 MAR 21 1979  
 3-21-79  
 CONSERVATION DIVISION  
 Wichita, Kansas