


STATE OF KANSAS  
STATE CORPORATION COMMISSION

WELL PLUGGING RECORD

Give All Information Completely  
Make Required Affidavit  
Mail or Deliver Report to  
Conservation Division  
State Corporation Comm.  
245 North Water  
Wichita, KS 67202

Commanche County, Sec. 5 Twp. 34S Rge. 17W ~~XXX~~  
Location as "NE/CNW $\frac{1}{4}$ SW $\frac{1}{4}$ " or footage from lines \_\_\_\_\_  
C-NE-NW (677' FNL & 1980' FWL Section 5)  
Lease Owner Union Oil Company of California  
Lease Name Hazel Beals Well No. 1  
Office Address 2000 Classen Center South Bldg.  
Oklahoma City, Oklahoma 73106  
Character of Well (Completed as Oil, Gas or Dry Hole) Gas

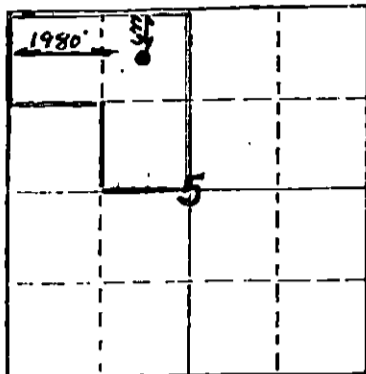

Date Well completed December 19, 1955  
Application for plugging filed September 22, 1981  
Application for plugging approved November 5, 1981  
Plugging commenced January 19, 1982  
Plugging completed January 23, 1982  
Reason for abandonment of well or producing formation  
Well depleted - no other shows  
If a producing well is abandoned, date of last production  
July 1979

Was permission obtained from the Conservation Division or its agents before plugging was commenced? Yes

Name of Conservation Agent who supervised plugging of this well Paul Luthi  
Producing formation Lansing KC Depth to top 4393' Bottom 4416' Total Depth of Well 5940'  
Show depth and thickness of all water, oil and gas formations.

OIL, GAS OR WATER RECORDS

CASING RECORD

FORMATION	CONTENT	FROM	TO	SIZE	PUT IN	PULLED OUT
Lansing KC	Gas	4393'	4416'	13 3/8"	246'	None
Marmaton	"	4948'	4948'	8 5/8"	2592'	None
Simpson	"	5088'	5736'	5 1/2"	5799'	3500'

Describe in detail the manner in which the well was plugged, indicating where the mud fluid was placed and the method or methods used in introducing it into the hold. If cement or other plugs were used, state the character of same and depth placed, from Surface feet to 5940' feet for each plug set. 12/55 Cement 5940' to 5799'. 6/78 Set CIBP @ 5000' & squeezed perf's 5084-5736'. 7/78 Set CIBP @ 4830' cement from 4830-4822'. 1/19/82 MIRU Lillard Casing Pullers Inc. loaded hole w/10# drlg. mud from 4822'-4250', spotted 40 sx. cmt. plug 4250'-4050'. Shot 5 1/2" casing off @ 3500' & pulled 110 jts. 5 1/2" csg. (3500'). Loaded hole w/10# drlg. mud from 4050'-2650' & spotted 50 sx. cmt. plug from 2650' to 2550', spotted 10# drlg. mud from 2550' to 40', 10 sx. cmt. plug from 40' to surface. Cut 13-3/8" & 8-5/8" csg. off below ground level & welded on steel cap. Cleaned up location. Well plugged & abandoned 1-23-82.

(If additional description is necessary, use BACK of this sheet)

Name of Plugging Contractor Lillard Casing Pullers Inc. - Woodward, Oklahoma

STATE OF Oklahoma COUNTY OF Oklahoma, ss. J. D. Norman (employee ~~XXXXXXXXXXXXXXXXXXXXXXXXXXXX~~)

of the above-described well, being first duly sworn on oath, says: That I have knowledge of the facts, statements, and matters herein contained and the log of the above-described well as filed and that the same are true and correct. So help me God.

(Signature) J. D. Norman Senior Clerk  
Oklahoma City, Oklahoma 73106

SUBSCRIBED AND SWORN TO before me this 25th day of January, 19 82

My commission expires August 22, 1982  
Honda Cooper Notary Public.  
STATE CORPORATION COMMISSION

JAN 27 1982  
1-27-82  
CONSERVATION DIVISION  
Wichita Kansas